Client:

EASTERN HOUSING LAHORE

Project:

TARIQ MASJID

ARCHITECTURAL DRAWINGS

AHMED IBRAHIM ARCHITECTS

ARCHITECTURE | INTERIOR DESIGN | CONSTRUCTION
PLANNING | DESIGN | LANDSCAPE

288 G1 Johar town Lahore
aia.designteam@gmail.com

LIST OF DRAWINGS


SR.NO.	DRAWING TITLE	DWG.NO.	PAGE NO.
	COVER PAGE		
	3D VIEW		
	LIST OF DRAWINGS		
	LAYOUT DRAWINGS		
1	LEGEND, GENERAL NOTES AND ABBREVIATION	AR-01	1
2	SITE PLAN	AR-02	2
3	GROUND FLOOR LAYOUT PLAN	AR-03	3
4	ROOF TOP LAYOUT PLAN	AR-04	4
	WORKING DRAWINGS		
5	GROUND FLOOR WORKING PLAN	AR-05	5
6	NORTH SIDE ELEVATION	AR-06	6
7	WEST SIDE ELEVATION	AR-07	7
8	SOUTH SIDE ELEVATION	AR-08	8
9	EAST SIDE ELEVATION	AR-09	9
10	SECTIONAL ELEVATION-A	AR-10	10
11	SECTIONAL ELEVATION-B	AR-11	11
12	GROUND FLOOR DETAILED MARKED PLAN	AR-12	12
13	TOILET PLAN (DETAIL-1)	AR-13	13
14	TOILET ELEVATION, SECTIONS (DETAIL-1)	AR-14	14
15	ABLUTION PLAN (DETAIL-2)	AR-15	15
16	ABLUTION ELEVATION, SECTIONS (DETAIL-2)	AR-16	16
17	ABLUTION SECTION (DETAIL-2)	AR-17	17
18	WATER BODY PLAN & ELEVATION (DETAIL-3)	AR-18	18
19	WATER BODY SECTION (DETAIL-3)	AR-19	19
20	HUJRA PLAN & ELEVATION (DETAIL-4)	AR-20	20
21	HUJRA PLAN & SECTION (DETAIL-4)	AR-21	21
22	SOUTH SIDE WALL PLAN, ELEVATION & SECTION (DETAIL-5)	AR-22	22
23	PRAYER HALL ENTRANCE WALL ELEVATION & SECTION (DETAIL-6)	AR-23	23
24	WEST SIDE WALL PLAN, ELEVATION & SECTION (DETAIL-7)	AR-24	24
25	MS FRAME PLAN (DETAIL-8)	AR-25	25
26	MS FRAME SECTION (DETAIL-8)	AR-26	26
27	MINAR (DETAIL-9)	AR-27	27
28	BOUNDARY WALL & DOOR WINDOW SCHEDULE (DETAIL-10)	AR-30	28

AHMED IBRAHIM ARCHITECTS

ARCHITECTURE | INTERIOR DESIGN | CONSTRUCTION
PLANNING | DESIGN | LANDSCAPE

288 G1 Johar town Lahore
aia.designteam@gmail.com

LEGEND

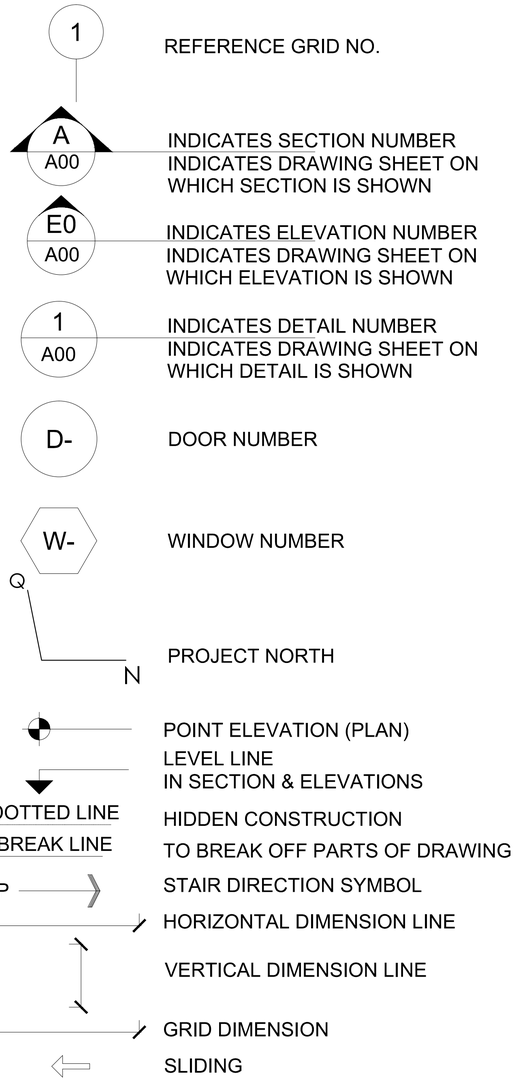


ABBREVIATIONS

C/C	CENTER TO CENTER
COL	COLUMN
COMM. PLY	COMMERCIAL PLY
CL	CONCRETE LEVEL
CM	CENTIMETER
CS	CEMENT SAND
D	DOOR
DW	DOOR WINDOW
EQ.	EQUAL
FFL	FINISHED FLOOR LEVEL
FT	FLOOR TRAP
MM	MILLIMETER
M	METER
NSL	NATURAL SURFACE LEVEL
PCC	PLAIN CEMENT CONCRETE
PL	PLINTH LEVEL
R	RISER
RCC	REINFORCED CEMENT
C.CON	CONCRETE
RL	ROAD LEVEL
T	TREAD
TH.	THICKNESS, THICK
TYP.	TYPICAL
V	VENTILATOR
W	WINDOW
WB	WASH BASIN
WC	WATER CLOSET
ELE.	ELEVATION

GENERAL NOTES

1. ALL DIMENSIONS ARE IN FEET / INCHES UNLESS OTHERWISE MENTIONED.
2. WRITTEN DIMENSIONS SHALL GOVERN NO DIMENSION SHALL BE SCALED.
3. FOR DIMENSIONS OF STRUCTURAL MEMBERS SUCH AS RCC COLUMNS, BEAMS AND SLABS ETC. REFER TO STRUCTURAL DRAWINGS.
4. THE DRAWINGS SHALL BE READ IN CONJUNCTION WITH STRUCTURAL, ELECTRICAL & PLUMBING DRAWINGS
5. CONTRACTOR SHALL BE RESPONSIBLE FOR THE SAFETY OF THE STRUCTURE DURING CONSTRUCTION. HE SHALL VERIFY ALL DIMENSIONS AND LEVELS BEFORE EXECUTION OF WORK. ANY DISCREPANCY, ERROR OR OMISSION IF FOUND SHALL BE BROUGHT TO THE NOTICE OF ENGINEER FOR CORRECTION & APPROVAL.
6. ALL WORKS PERTAINING TO SERVICES, SUCH AS WATER SUPPLY, SEWERAGE AND DRAINAGE, ELECTRICITY, GAS AND TELEPHONE SHALL BE CARRIED OUT IN ACCORDANCE WITH THE RULES AND REGULATIONS OF CONCERNED AUTHORITIES.
7. COLOUR SHADES AND QUALITY OF PAINTS, CERAMIC TILES, MARBLE TILES, WATER SUPPLY AND SANITARY FITTINGS ETC. ARE SUBJECT TO THE APPROVAL OF THE ENGINEER.
8. THE SHOP DRAWINGS WHERE APPLICABLE SHALL BE SUBJECT TO PRIOR APPROVAL OF THE ENGINEER.

Building North:

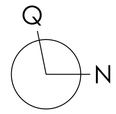

Project Name & Address:

TARIQ MASJID

Client Name:

EASTERN HOUSING

Project number:	Drawing Number:
2024.09.0021	AR-01

Sheet Title: LEGEND, GENERAL NOTES AND ABBREVIATION

Date Created:	Scale:
24-07- 2024	N.T.S

Design by :	Drawn by :	Check by :
ALI HAMZA	MONAM ALI	A.Ibrahim

GENERAL NOTES :

RECORD DRAWING

DATE	REV#	DESCRIPTION

KEY PLAN:

This drawing is to be read in conjunction with all related dwgs. Do not scale from this drawing. All dimensions must be checked and verified on site before commencing any work or producing shop drawings. The originator should be notified immediately of any discrepancy.
This drawing is copyright and remains the property of AIA.


AHMED IBRAHIM ARCHITECTS

ARCHITECTURE | INTERIOR DESIGN | CONSTRUCTION
PLANNING | DESIGN | LANDSCAPE

288 G1 Johar town Lahore
aia.designteam@gmail.com

5 MARLA PLOTS
25'-0" x 45'-0"

30' WIDE ROAD

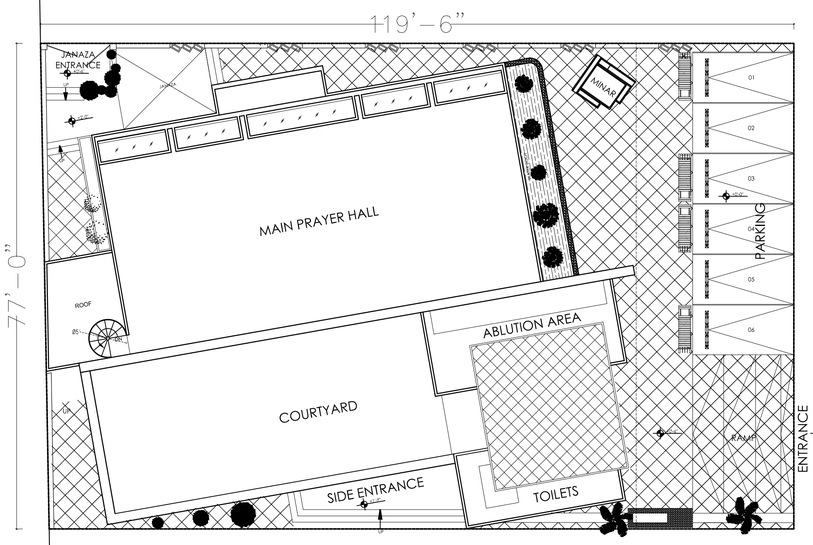

PASSAGE 10' WIDE

PARK

50' WIDE ROAD

40' WIDE ROAD

P/B FOR SPONSOR SCHOOL

PASSAGE 10' WIDE

P/B FOR LDA

PASSAGE 10' WIDE

APPARTMENTS

Q
N
SITE PLAN

Building North:

Q
N

Project Name & Address:

TARIQ MASJID

Client Name:

EASTERN HOUSING

Project number:	Drawing Number:
2024.09.0021	AR-02

Sheet Title:

SITE PLAN

Date Created:	Scale:
24-07- 2024	N.T.S

Design by :	Drawn by :	Check by :
ALI HAMZA	MONAM ALI	A.Ibrahim

GENERAL NOTES :

RECORD DRAWING

DATE	REV#	DESCRIPTION


KEY PLAN:

This drawing is to be read in conjunction with all related dwgs. Do not scale from this drawing. All dimensions must be checked and verified on site before commencing any work or producing shop drawings. The originator should be notified immediately of any discrepancy.
This drawing is copyright and remains the property of AIA.

AHMED IBRAHIM ARCHITECTS

ARCHITECTURE | INTERIOR DESIGN | CONSTRUCTION
PLANNING | DESIGN | LANDSCAPE

288 G1 Johar town Lahore
aia.designteam@gmail.com

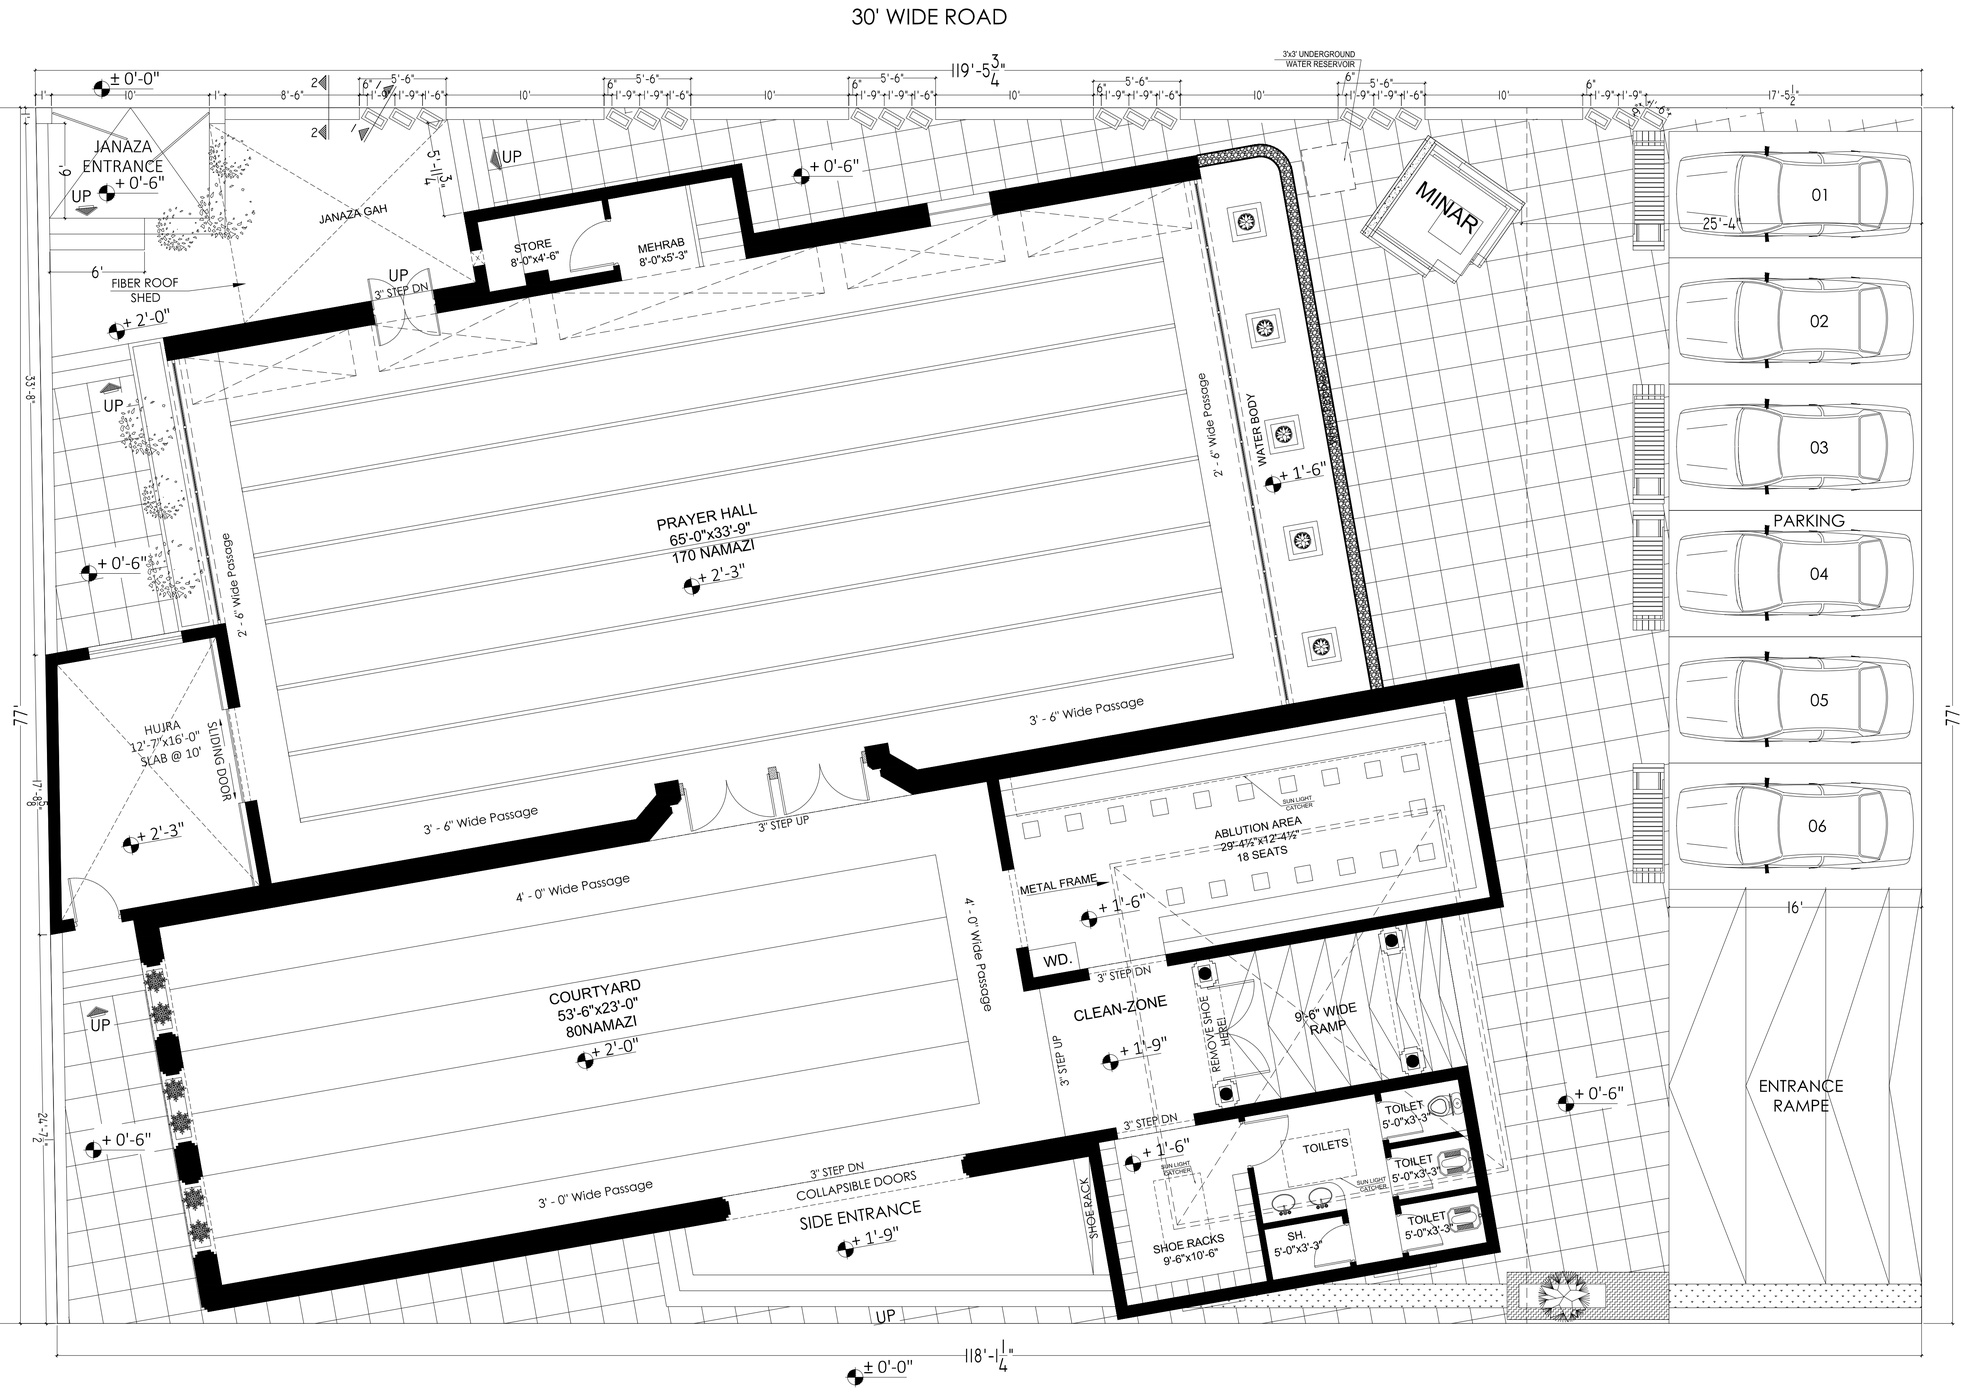

01 LAYOUT PLAN

PARK

Building North:

Q N

Project Name & Address:

TARIQ MASJID

Client Name:

EASTERN HOUSING

Project number:	Drawing Number:
2024.09.0021	AR-03

Sheet Title: GROUND FLOOR PROPOSED LAYOUT

Date Created:	Scale:
24-07- 2024	N.T.S

Design by :	Drawn by :	Check by :
ALI HAMZA	MONAM ALI	A.Ibrahim

GENERAL NOTES :

RECORD DRAWING

DATE	REVI	DESCRIPTION


KEY PLAN:

This drawing is to be read in conjunction with all related dwgs. Do not scale from this drawing. All dimensions must be checked and verified on site before commencing any work or producing shop drawings. The originator should be notified immediately of any discrepancy.
This drawing is copyright and remains the property of AIA.

AHMED IBRAHIM ARCHITECTS

ARCHITECTURE | INTERIOR DESIGN | CONSTRUCTION
PLANNING | DESIGN | LANDSCAPE

288 G1 Johar town Lahore
aia.designteam@gmail.com

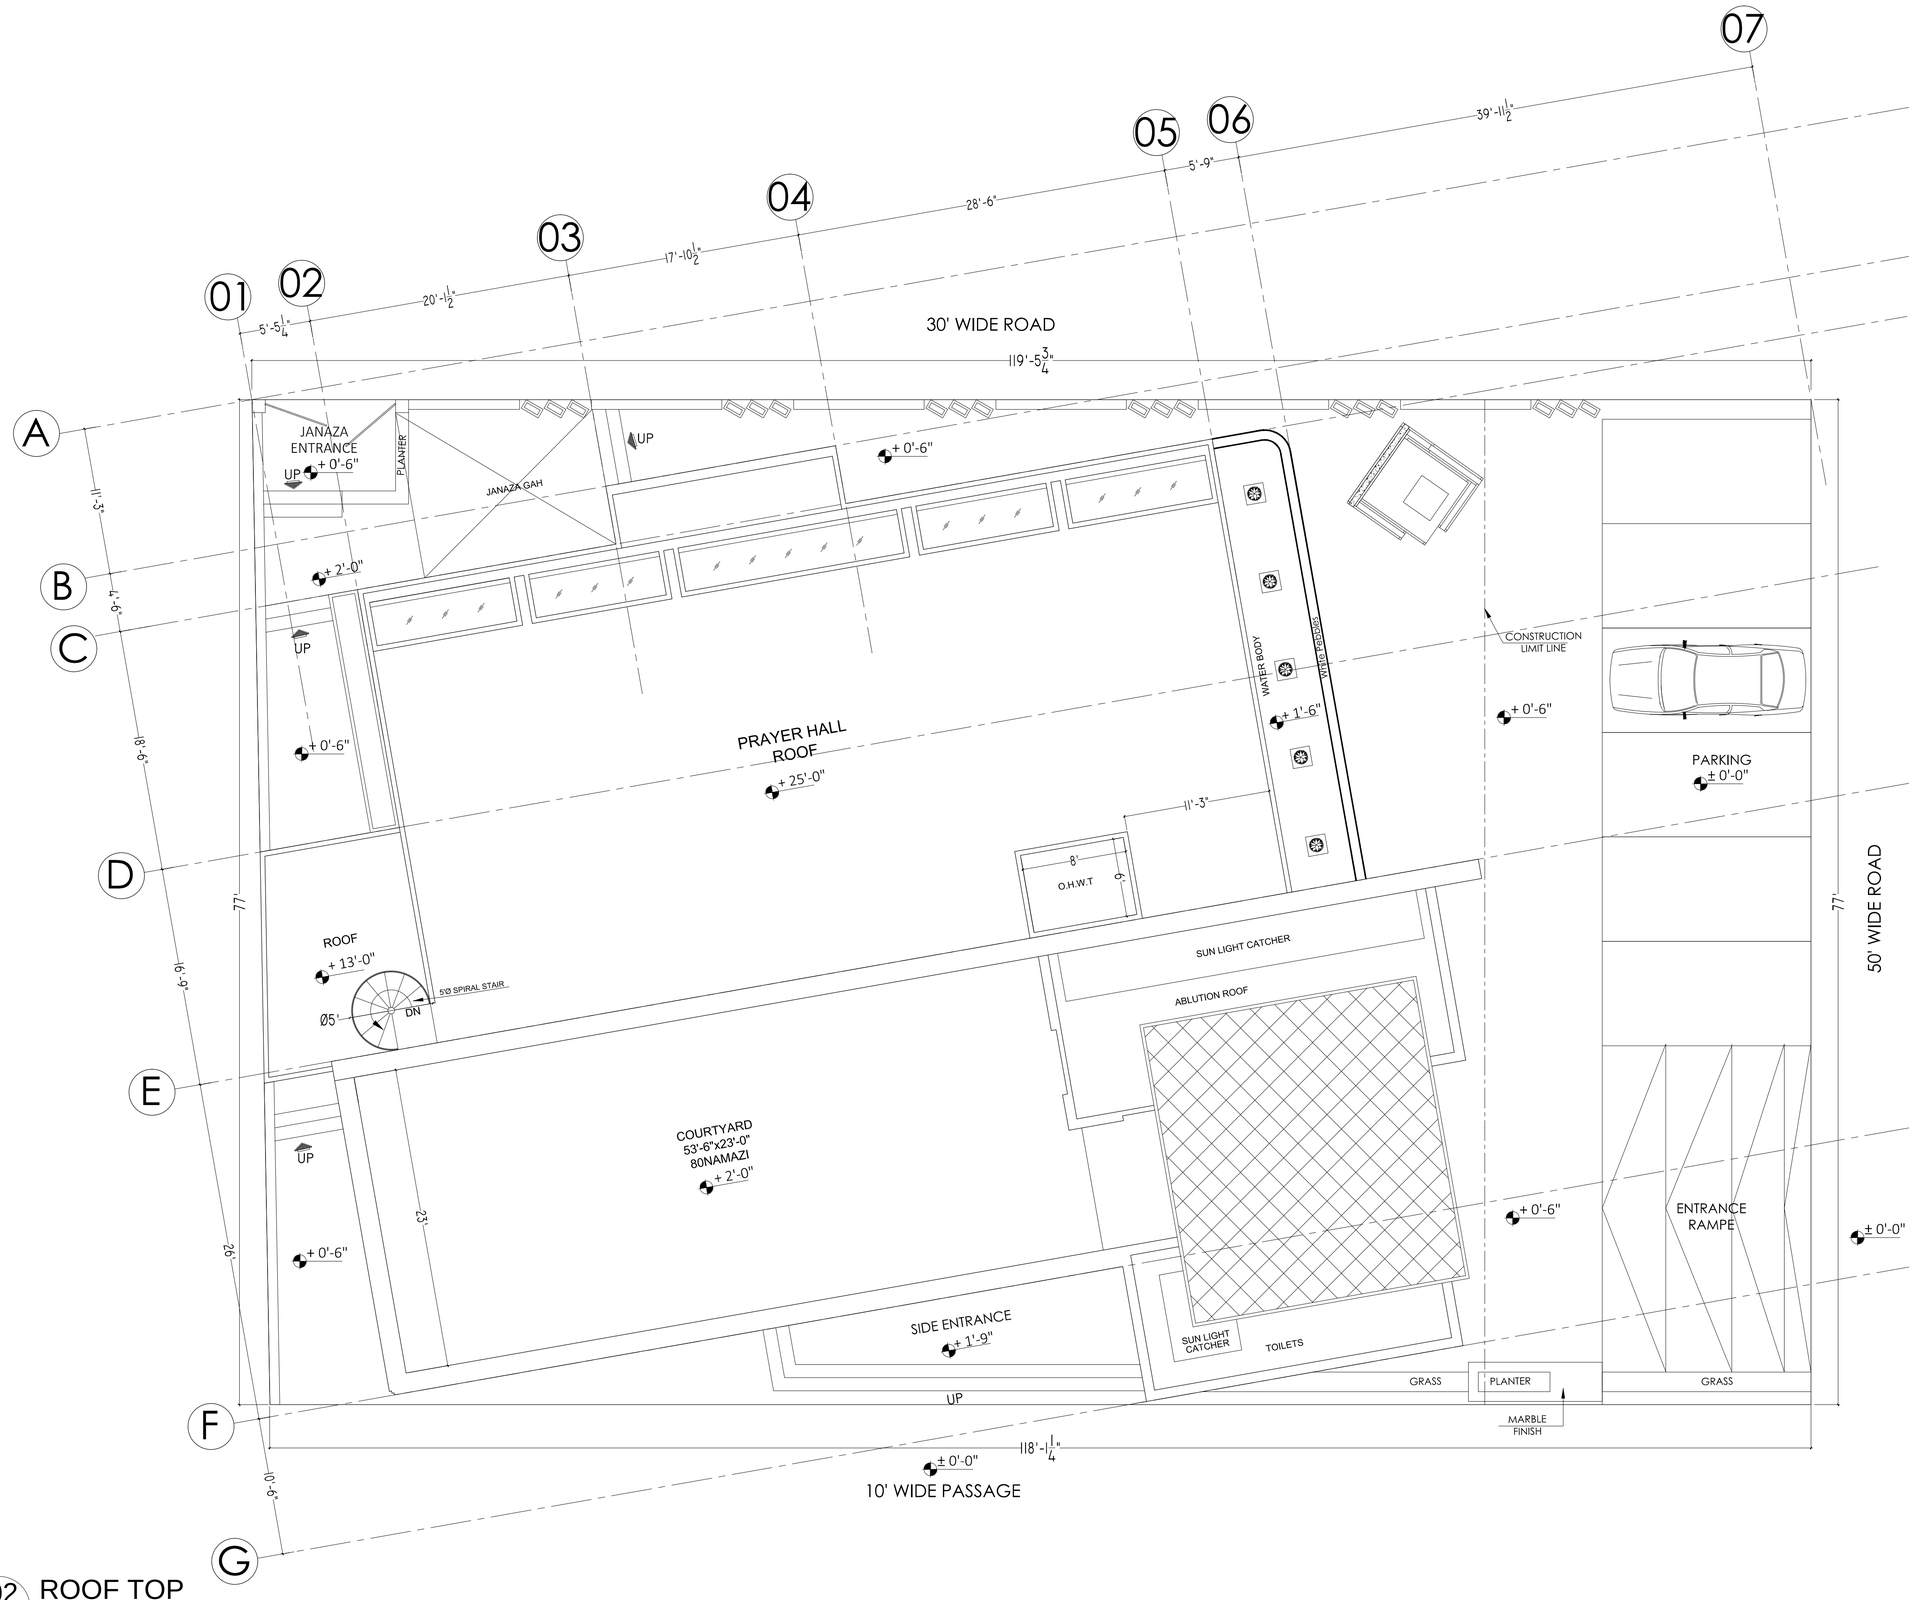

02 ROOF TOP PLAN

Building North:

Q N

Project Name & Address:

TARIQ MASJID

Client Name:

EASTERN HOUSING

Project number:	Drawing Number:
2024.09.0021	AR-04

Sheet Title: ROOF TOP

Date Created:	Scale:
24-07- 2024	N.T.S

Design by :	Drawn by :	Check by :
ALI HAMZA	MONAM ALI	A.Ibrahim

GENERAL NOTES :

RECORD DRAWING

DATE	REV#	DESCRIPTION


KEY PLAN:

This drawing is to be read in conjunction with all related dwgs. Do not scale from this drawing. All dimensions must be checked and verified on site before commencing any work or producing shop drawings. The originator should be notified immediately of any discrepancy.
This drawing is copyright and remains the property of AIA.

AHMED IBRAHIM ARCHITECTS

ARCHITECTURE | INTERIOR DESIGN | CONSTRUCTION
PLANNING | DESIGN | LANDSCAPE

288 G1 Johar town Lahore
aia.designteam@gmail.com

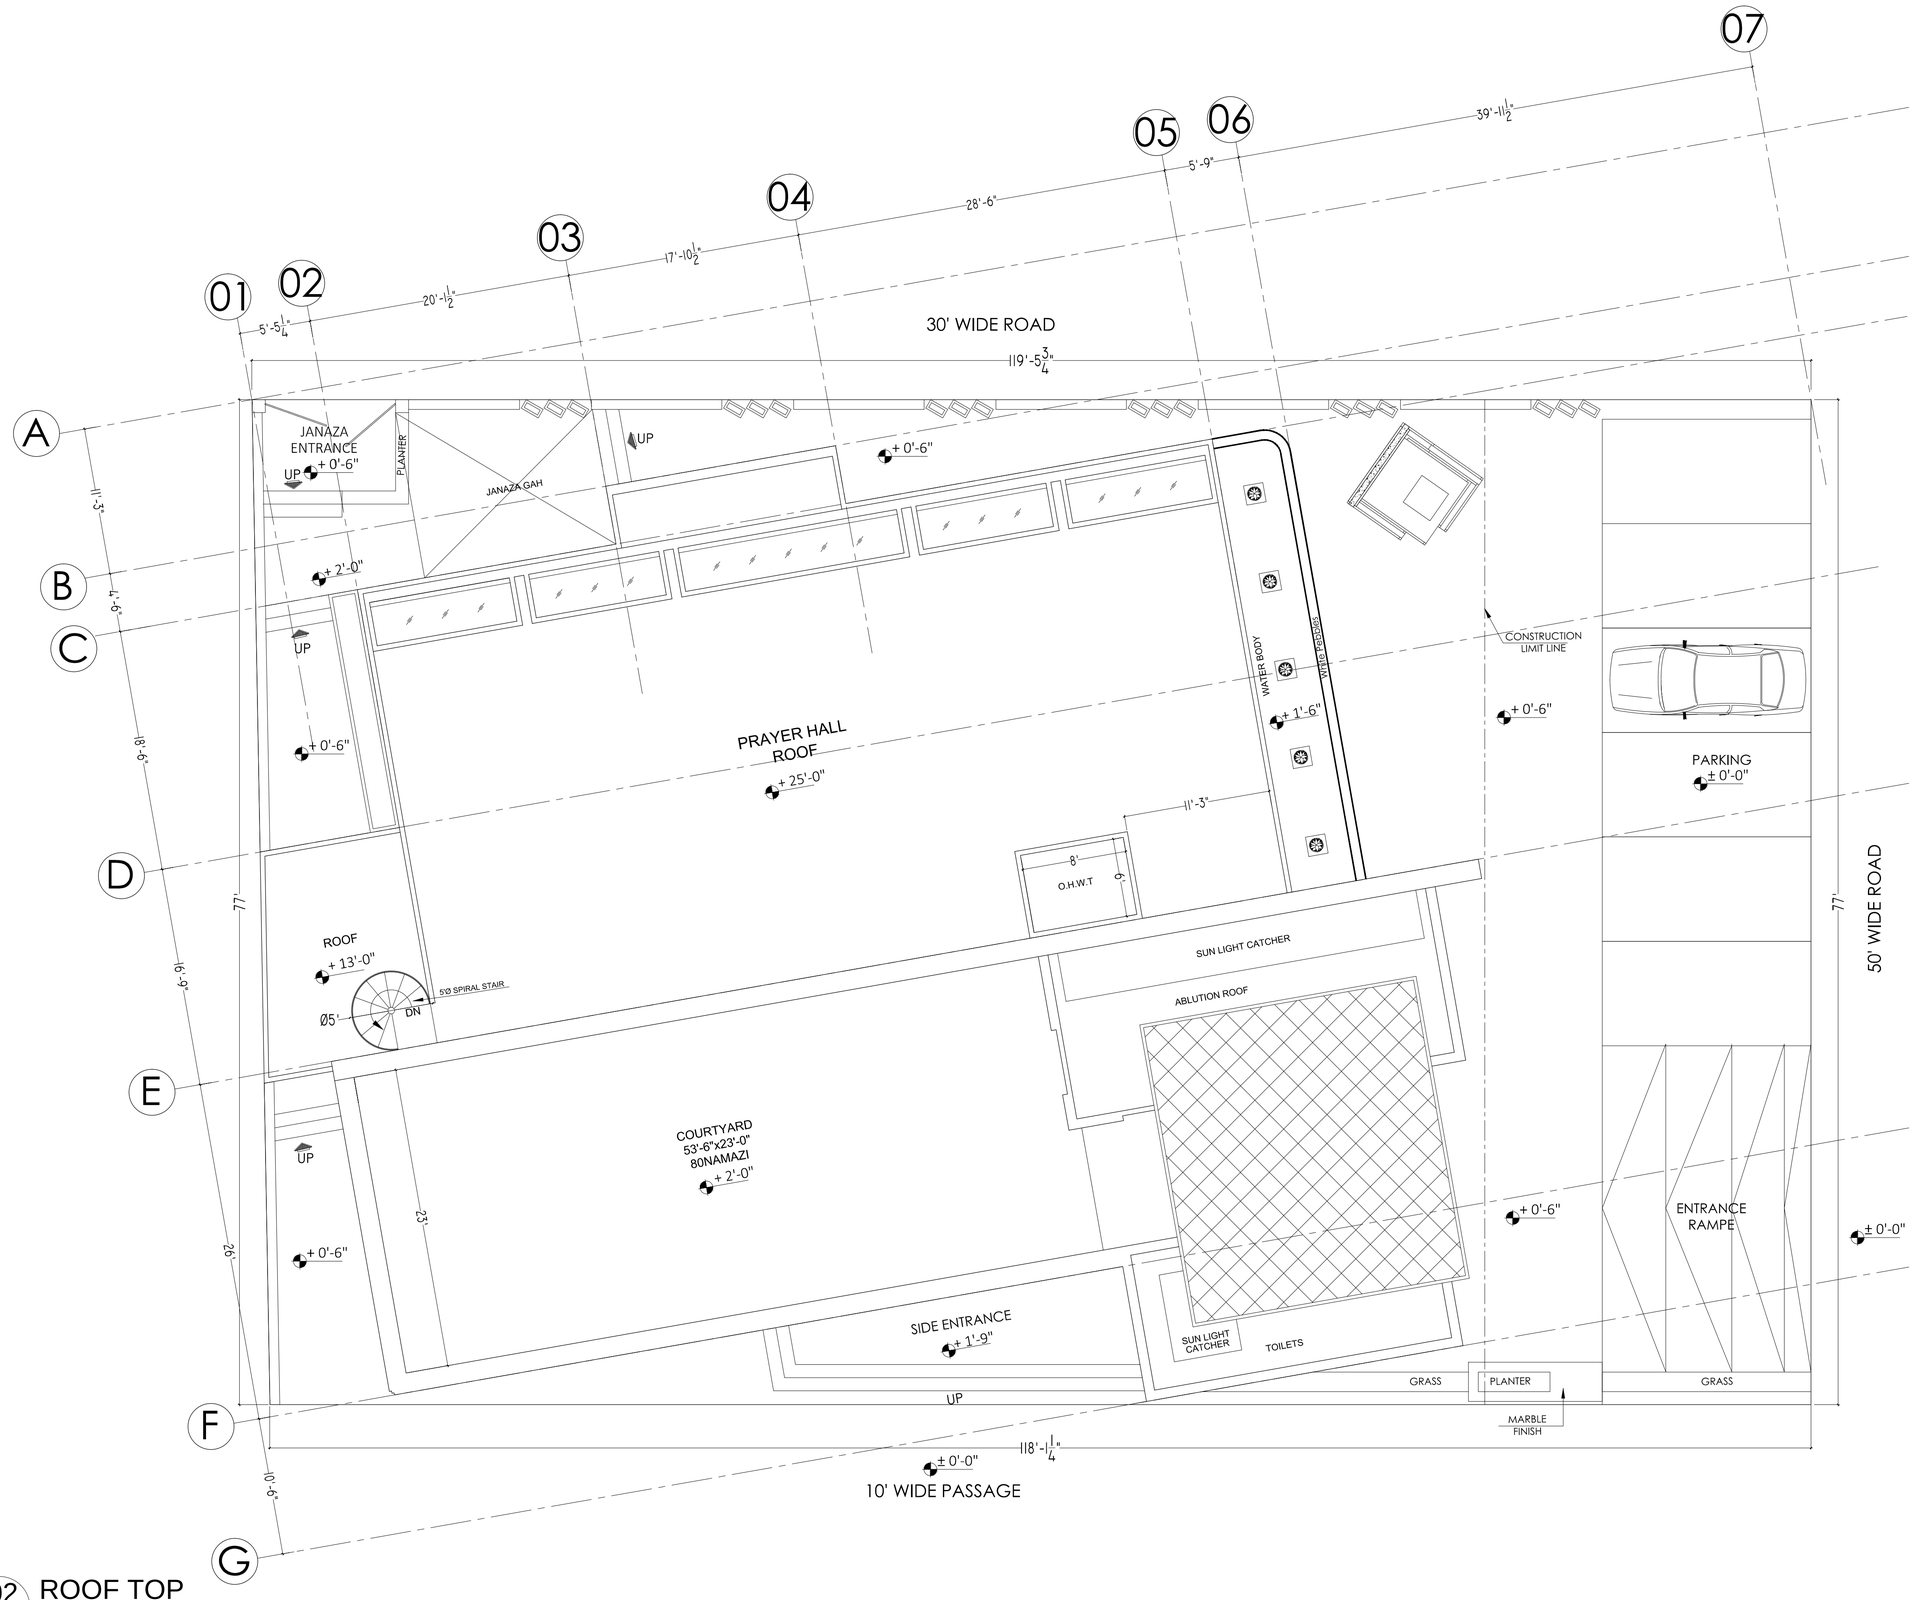

02 ROOF TOP PLAN

Building North:

Q N

Project Name & Address:

TARIQ MASJID

Client Name:

EASTERN HOUSING

Project number:	Drawing Number:
2024.09.0021	AR-04

Sheet Title: ROOF TOP

Date Created:	Scale:
24-07- 2024	N.T.S

Design by :	Drawn by :	Check by :
ALI HAMZA	MONAM ALI	A.Ibrahim

GENERAL NOTES :

RECORD DRAWING

DATE	REV#	DESCRIPTION


KEY PLAN:

This drawing is to be read in conjunction with all related dwgs. Do not scale from this drawing. All dimensions must be checked and verified on site before commencing any work or producing shop drawings. The originator should be notified immediately of any discrepancy.
This drawing is copyright and remains the property of AIA.

AHMED IBRAHIM ARCHITECTS

ARCHITECTURE | INTERIOR DESIGN | CONSTRUCTION
PLANNING | DESIGN | LANDSCAPE

288 G1 Johar town Lahore
aia.designteam@gmail.com

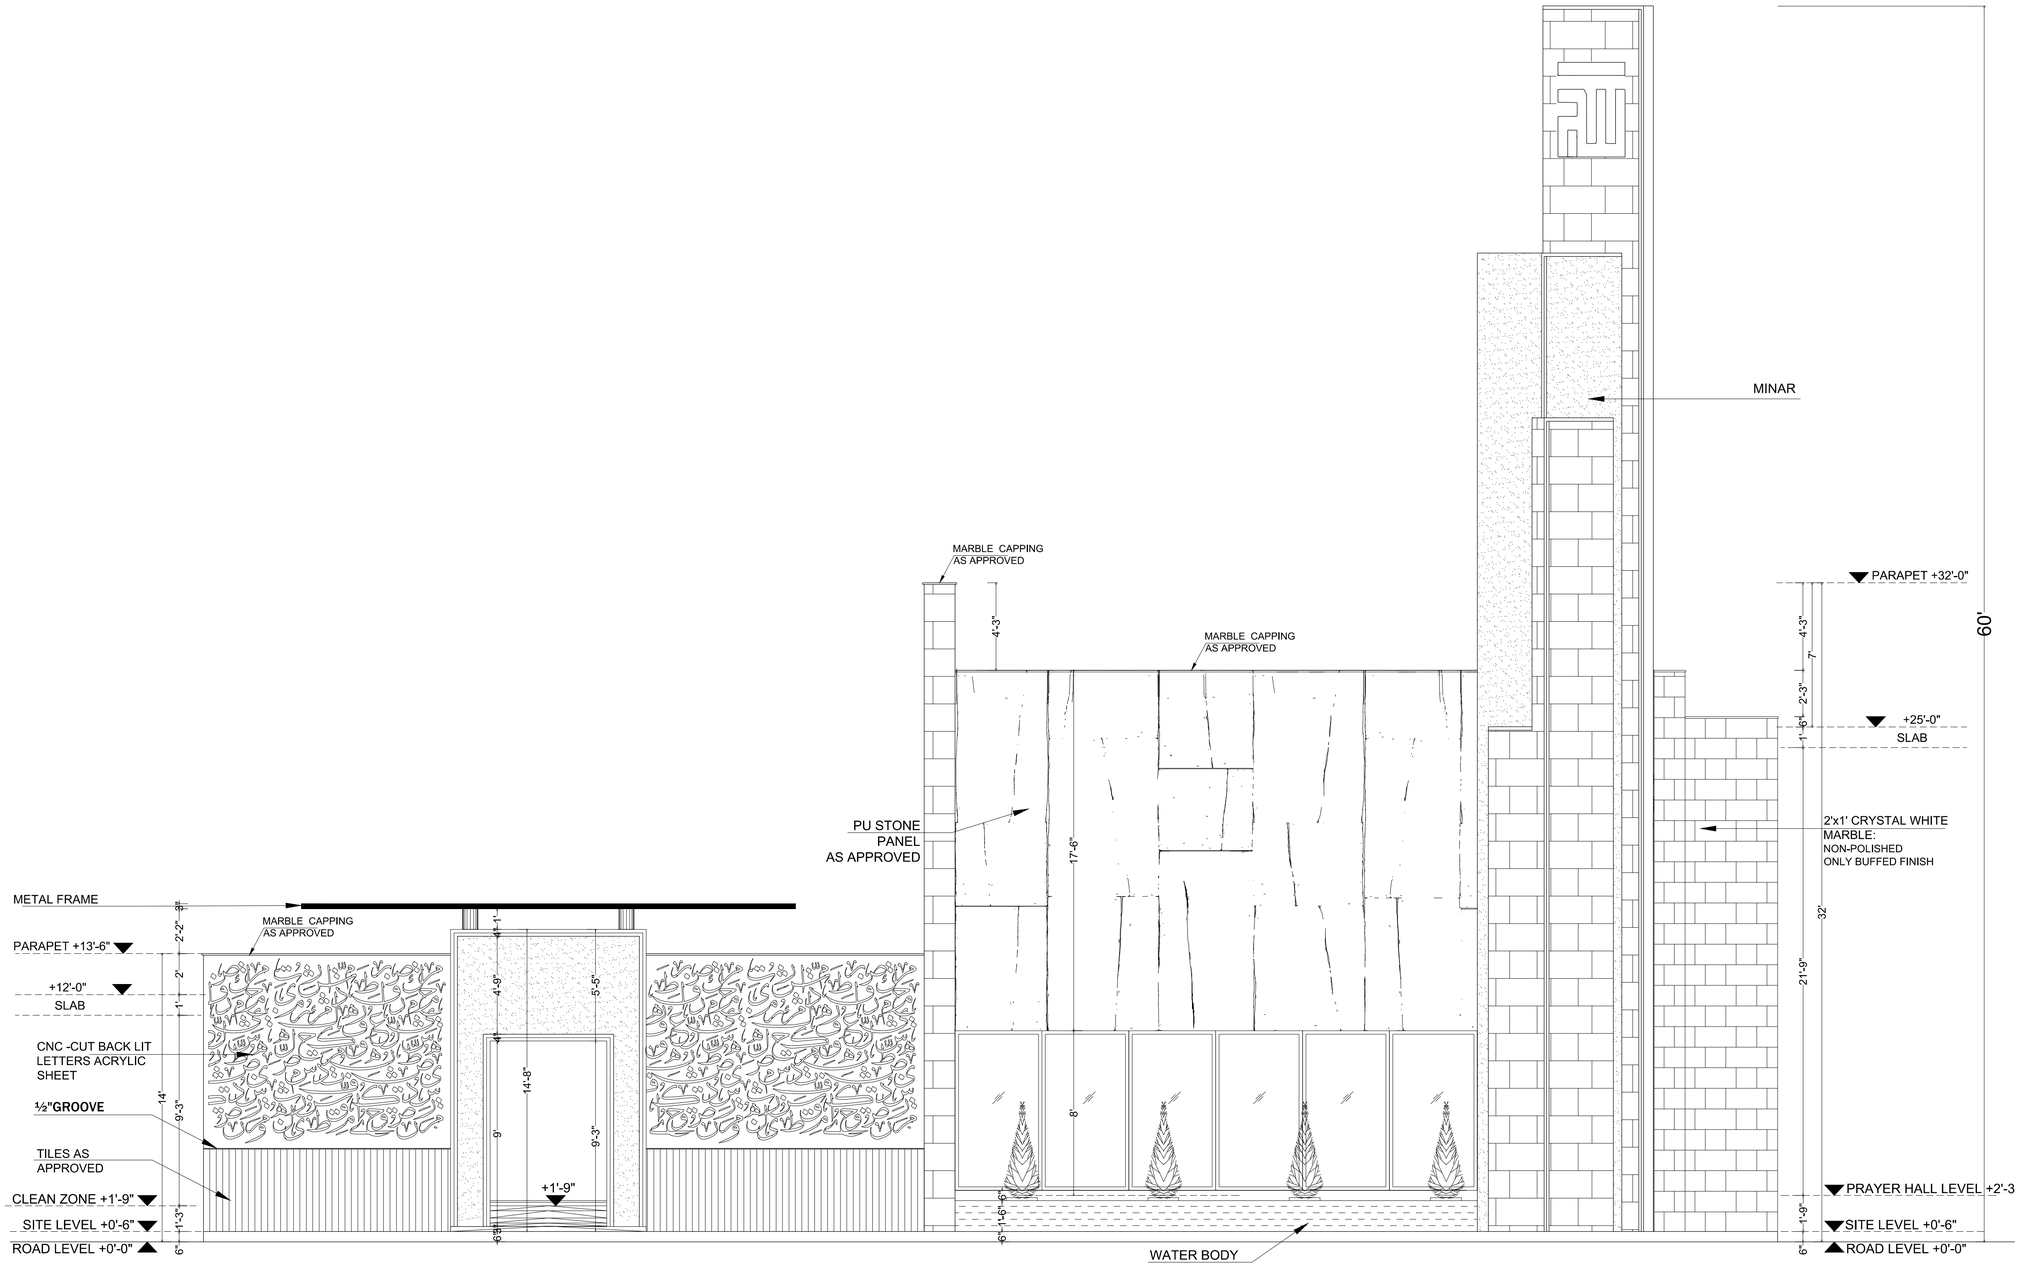

E1 NORTH SIDE ELEVATION
AR-03

Building North:

Q
N

Project Name & Address:

TARIQ MASJID

Client Name:

EASTERN HOUSING

Project number:	Drawing Number:
2024.09.0021	AR-06

Sheet Title:

REAR ELEVATION

Date Created:	Scale:
24-07- 2024	N.T.S

Design by :	Drawn by :	Check by :
ALI HAMZA	MONAM ALI	A.Ibrahim

GENERAL NOTES :

RECORD DRAWING

DATE	REV.	DESCRIPTION


KEY PLAN:

This drawing is to be read in conjunction with all related dwgs. Do not scale from this drawing. All dimensions must be checked and verified on site before commencing any work or producing shop drawings. The originator should be notified immediately of any discrepancy.
This drawing is copyright and remains the property of AIA.

AHMED IBRAHIM ARCHITECTS

ARCHITECTURE | INTERIOR DESIGN | CONSTRUCTION
PLANNING | DESIGN | LANDSCAPE

288 G1 Johar town Lahore
aia.designteam@gmail.com

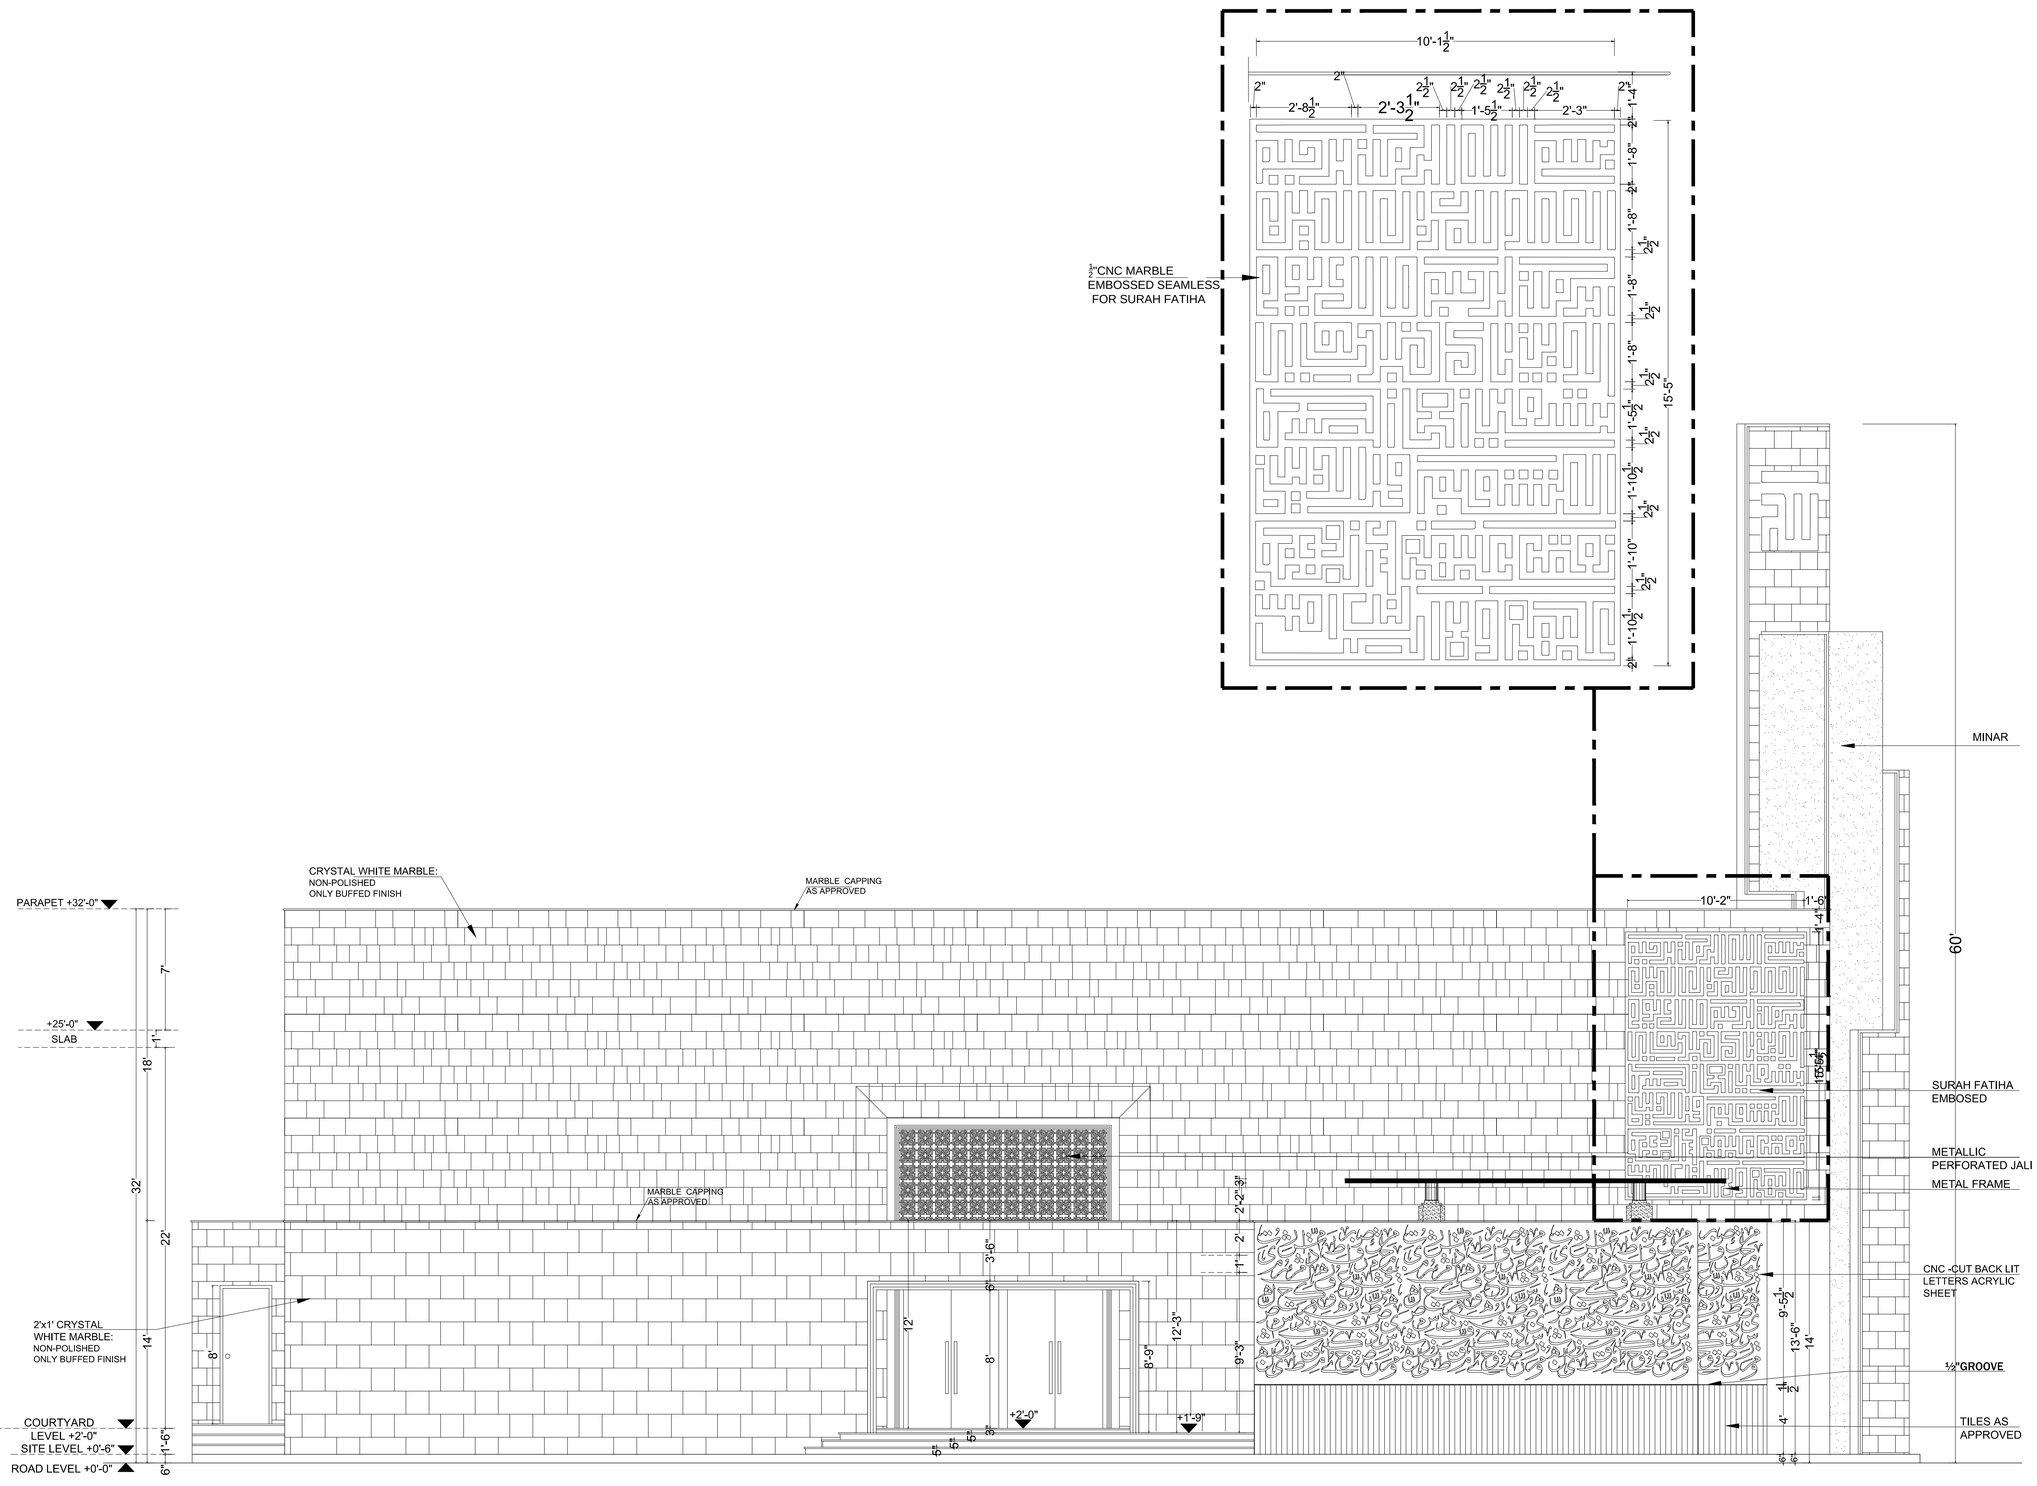

E2 WEST SIDE ELEVATION
AR-04

Building North:

Project Name & Address:

TARIQ MASJID

Client Name:

EASTERN HOUSING

Project number:	Drawing Number:
2024.09.0021	AR-07

Sheet Title:

WEST SIDE ELEVATION

Date Created:	Scale:
24-07- 2024	N.T.S

Design by :	Drawn by :	Check by :
ALI HAMZA	MONAM ALI	A.Ibrahim

GENERAL NOTES :

RECORD DRAWING

DATE	REVI	DESCRIPTION


KEY PLAN:

This drawing is to be read in conjunction with all related dwgs.
Do not scale from this drawing. All dimensions must be checked and verified on site before commencing any work or producing shop drawings. The originator should be notified immediately of any discrepancy.
This drawing is copyright and remains the property of AIA.

AHMED IBRAHIM ARCHITECTS


ARCHITECTURE | INTERIOR DESIGN | CONSTRUCTION
PLANNING | DESIGN | LANDSCAPE

288 G1 Johar town Lahore
aia.designteam@gmail.com

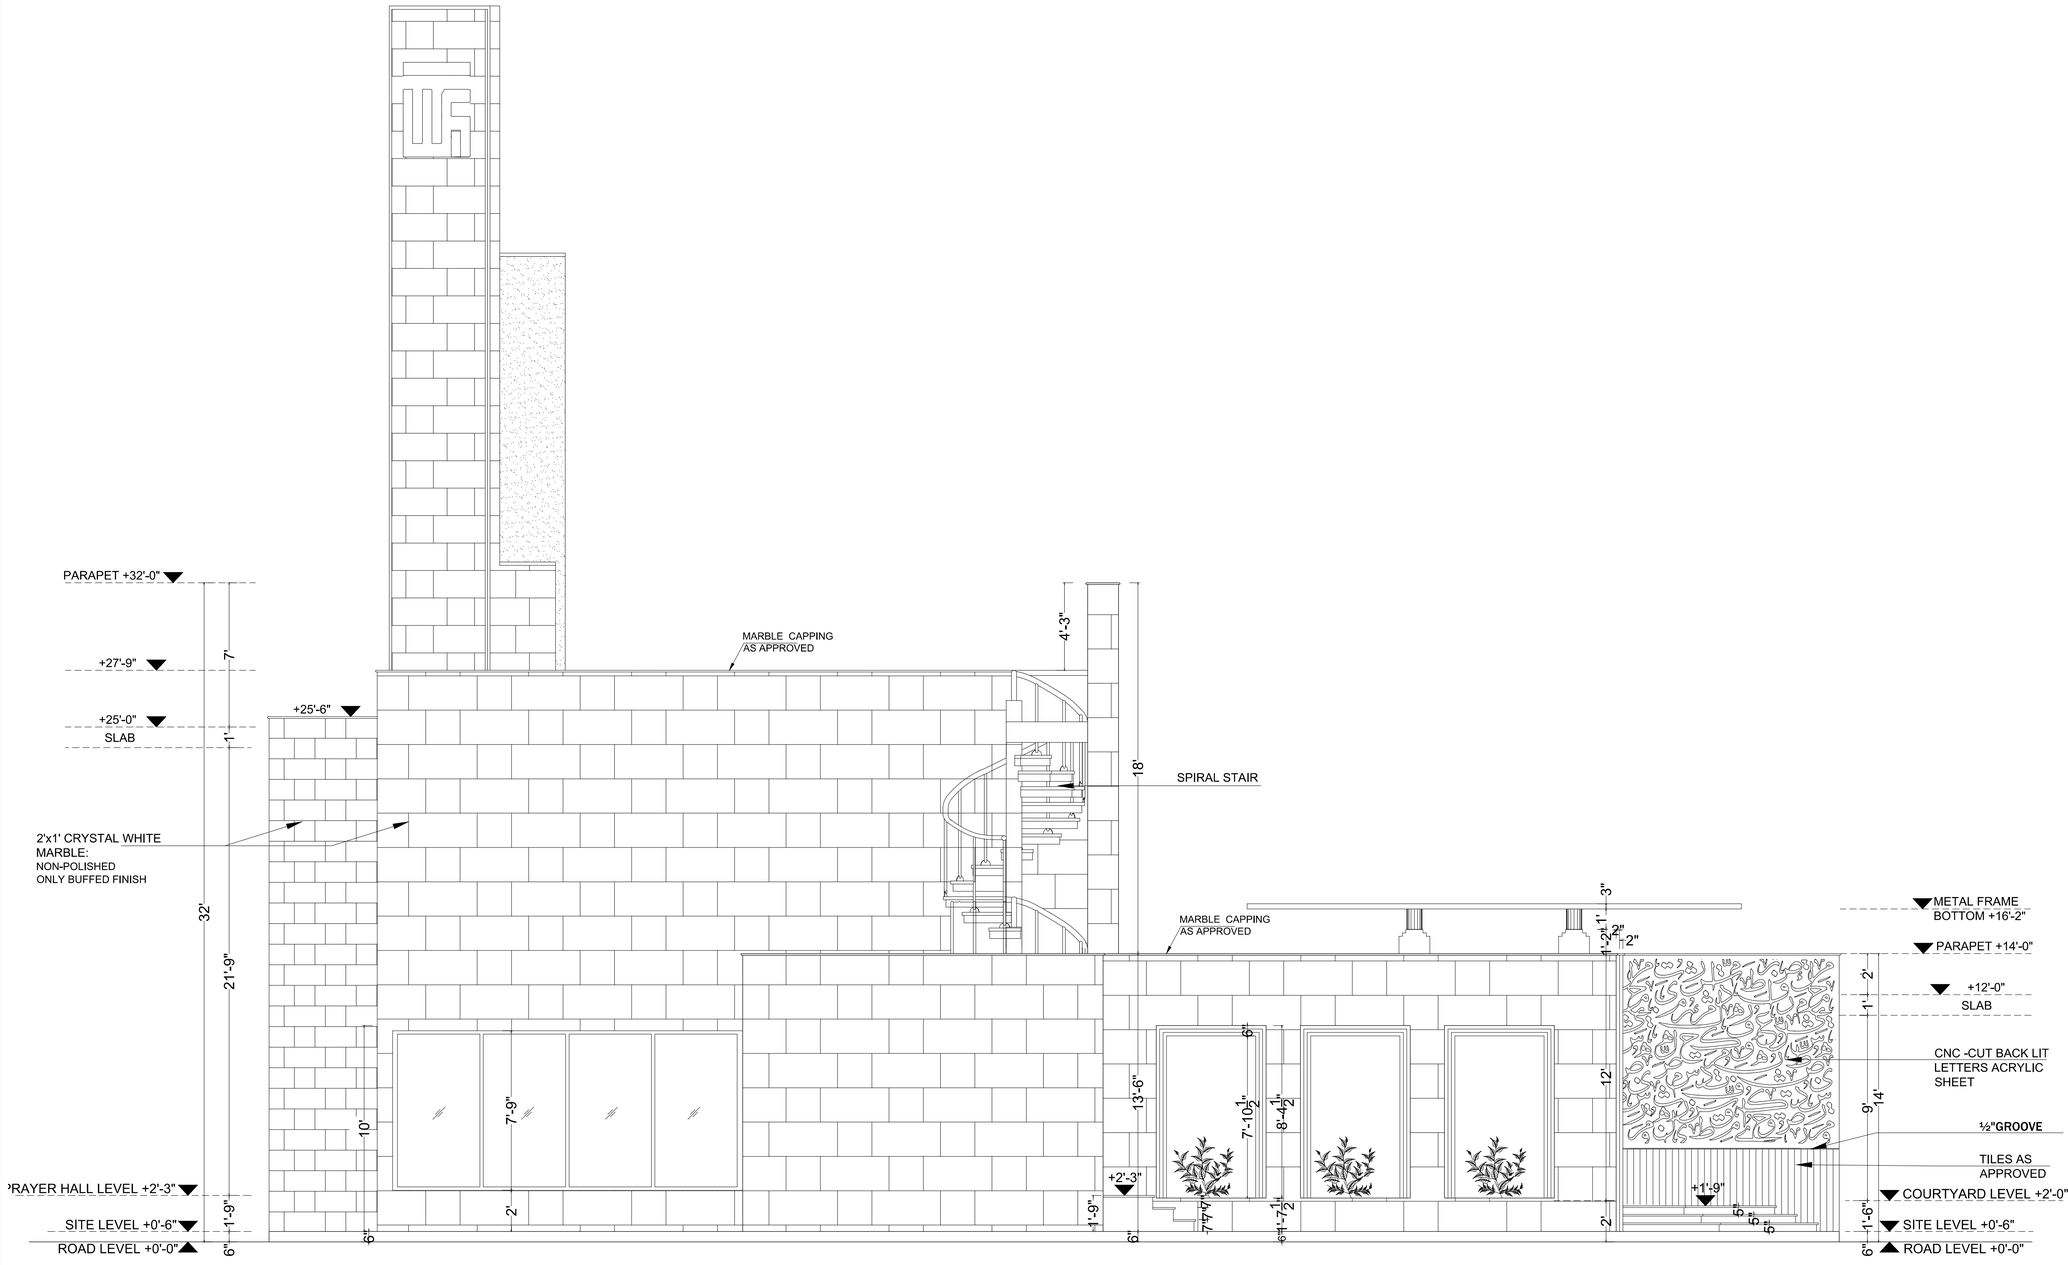

E3 AR-05 SOUTH SIDE ELEVATION

Building North:

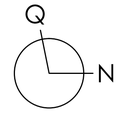

Project Name & Address:

TARIQ MASJID

Client Name:

EASTERN HOUSING

Project number:	Drawing Number:
2024.09.0021	AR-08

Sheet Title:

REAR ELEVATION

Date Created:	Scale:
24-07- 2024	N.T.S

Design by :	Drawn by :	Check by :
ALI HAMZA	MONAM ALI	A.Ibrahim

GENERAL NOTES :

RECORD DRAWING

DATE	REVI	DESCRIPTION


KEY PLAN:

This drawing is to be read in conjunction with all related dwgs. Do not scale from this drawing. All dimensions must be checked and verified on site before commencing any work or producing shop drawings. The originator should be notified immediately of any discrepancy.
This drawing is copyright and remains the property of AIA.

AHMED IBRAHIM ARCHITECTS

ARCHITECTURE | INTERIOR DESIGN | CONSTRUCTION
PLANNING | DESIGN | LANDSCAPE

288 G1 Johar town Lahore
aia.designteam@gmail.com

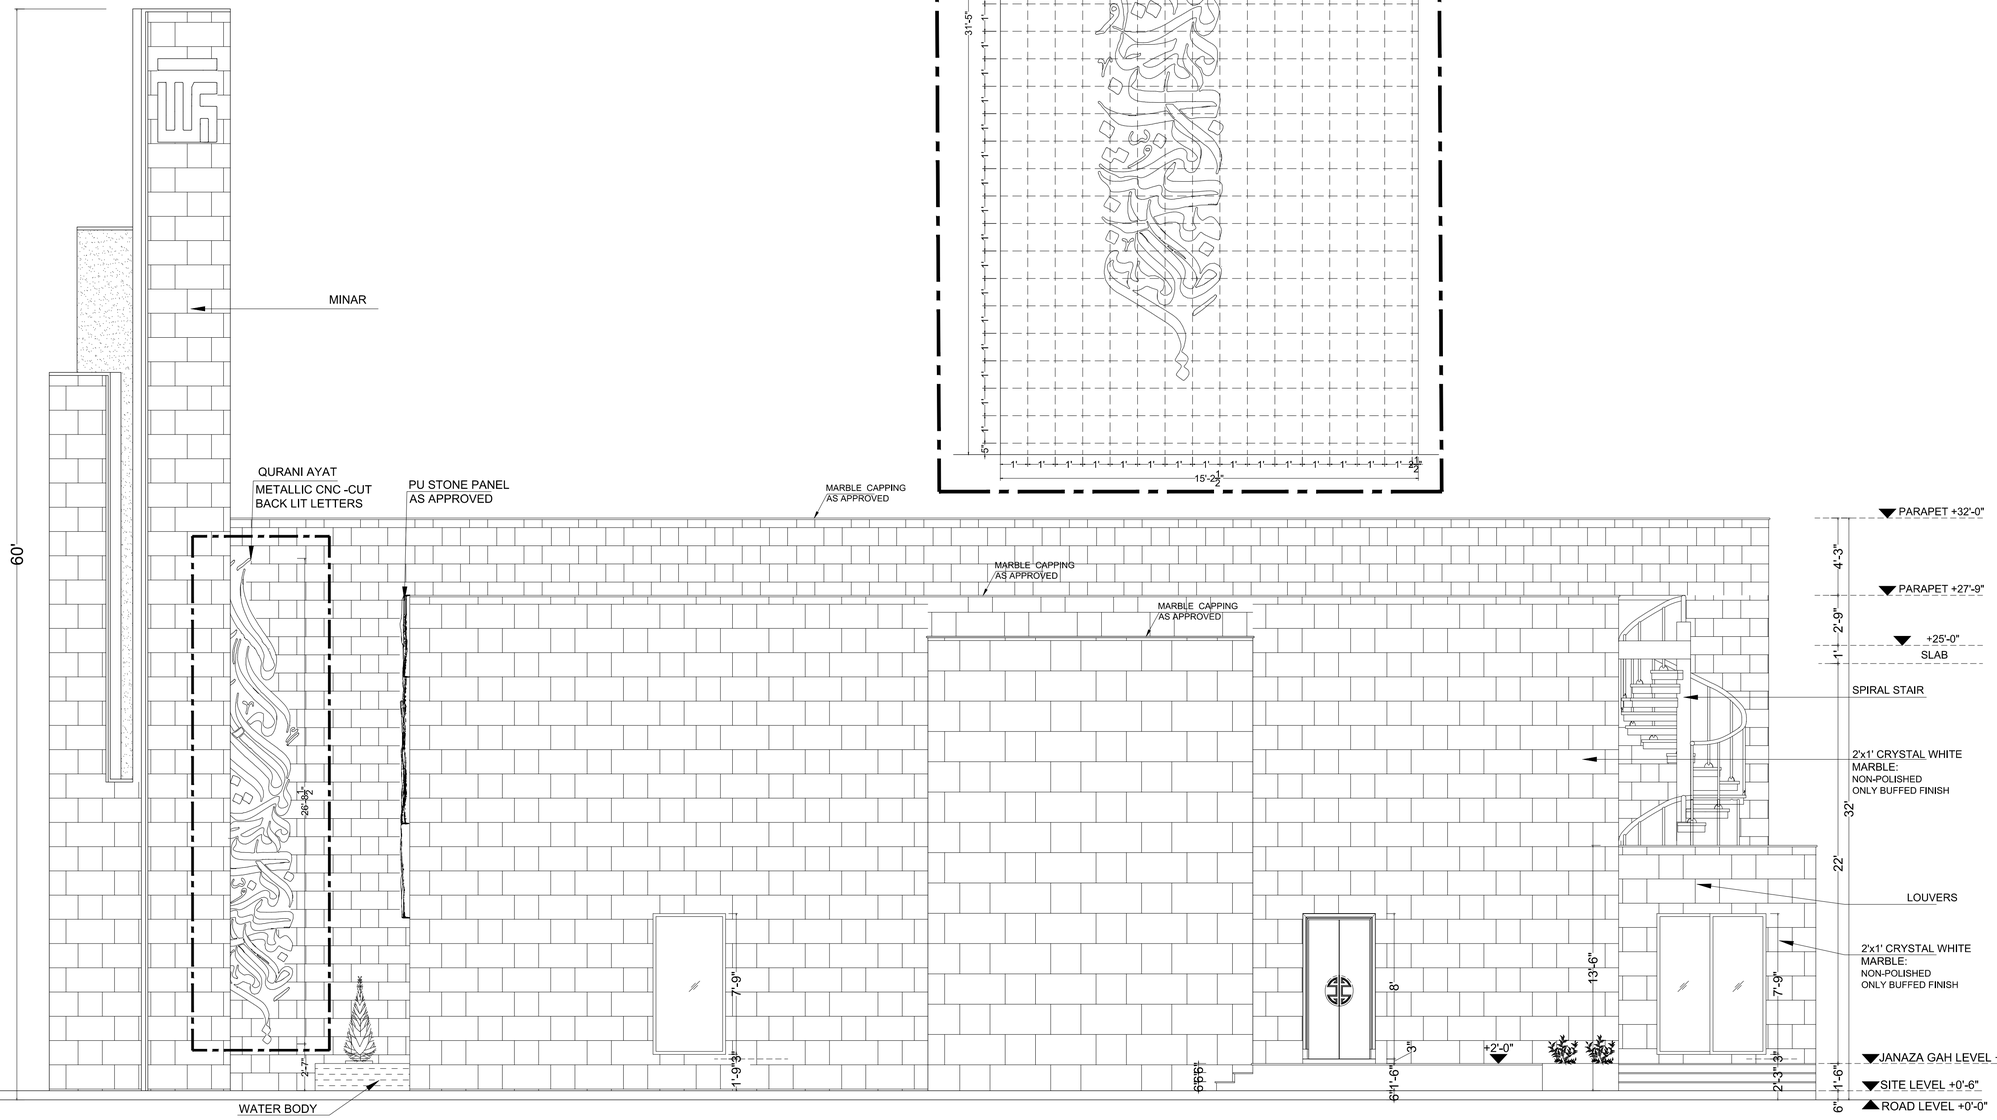

E4 EAST SIDE ELEVATION
AR-04

Building North:

Q
N

Project Name & Address:

TARIQ MASJID

Client Name:

EASTERN HOUSING

Project number:	Drawing Number:
2024.09.0021	AR-09

Sheet Title:

EAST SIDE ELEVATION

Date Created:	Scale:
24-07- 2024	N.T.S

Design by :	Drawn by :	Check by :
ALI HAMZA	MONAM ALI	A.Ibrahim

GENERAL NOTES :


RECORD DRAWING


DATE	REV#	DESCRIPTION


KEY PLAN:

This drawing is to be read in conjunction with all related dwgs. Do not scale from this drawing. All dimensions must be checked and verified on site before commencing any work or producing shop drawings. The originator should be notified immediately of any discrepancy.
This drawing is copyright and remains the property of AIA.

AHMED IBRAHIM ARCHITECTS
ARCHITECTURE | INTERIOR DESIGN | CONSTRUCTION
PLANNING | DESIGN | LANDSCAPE
288 G1 Johar town Lahore
aia.designteam@gmail.com

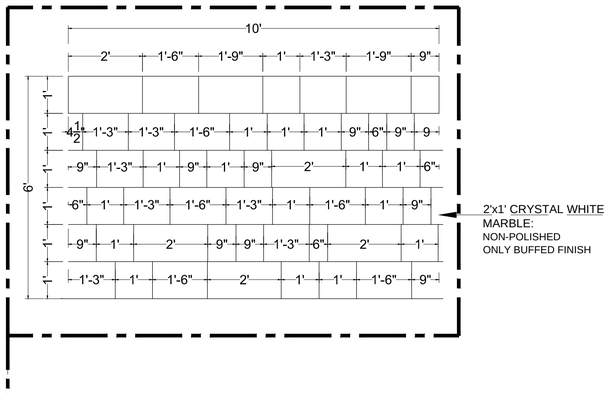

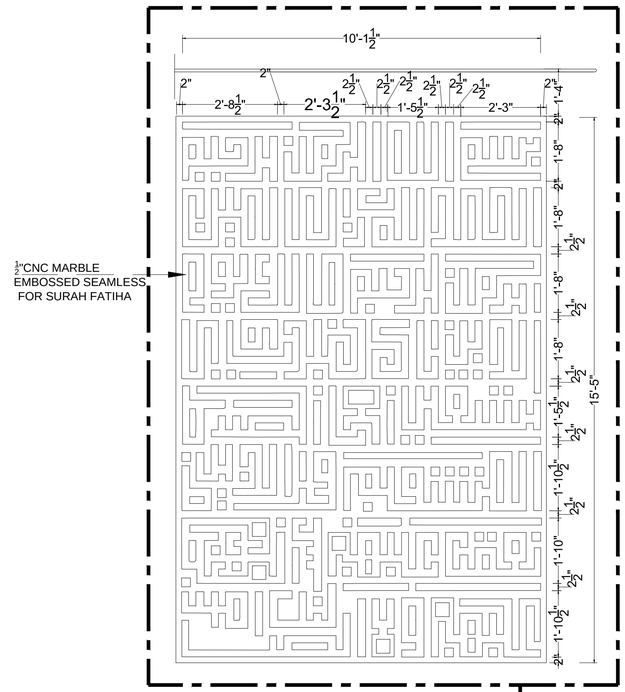

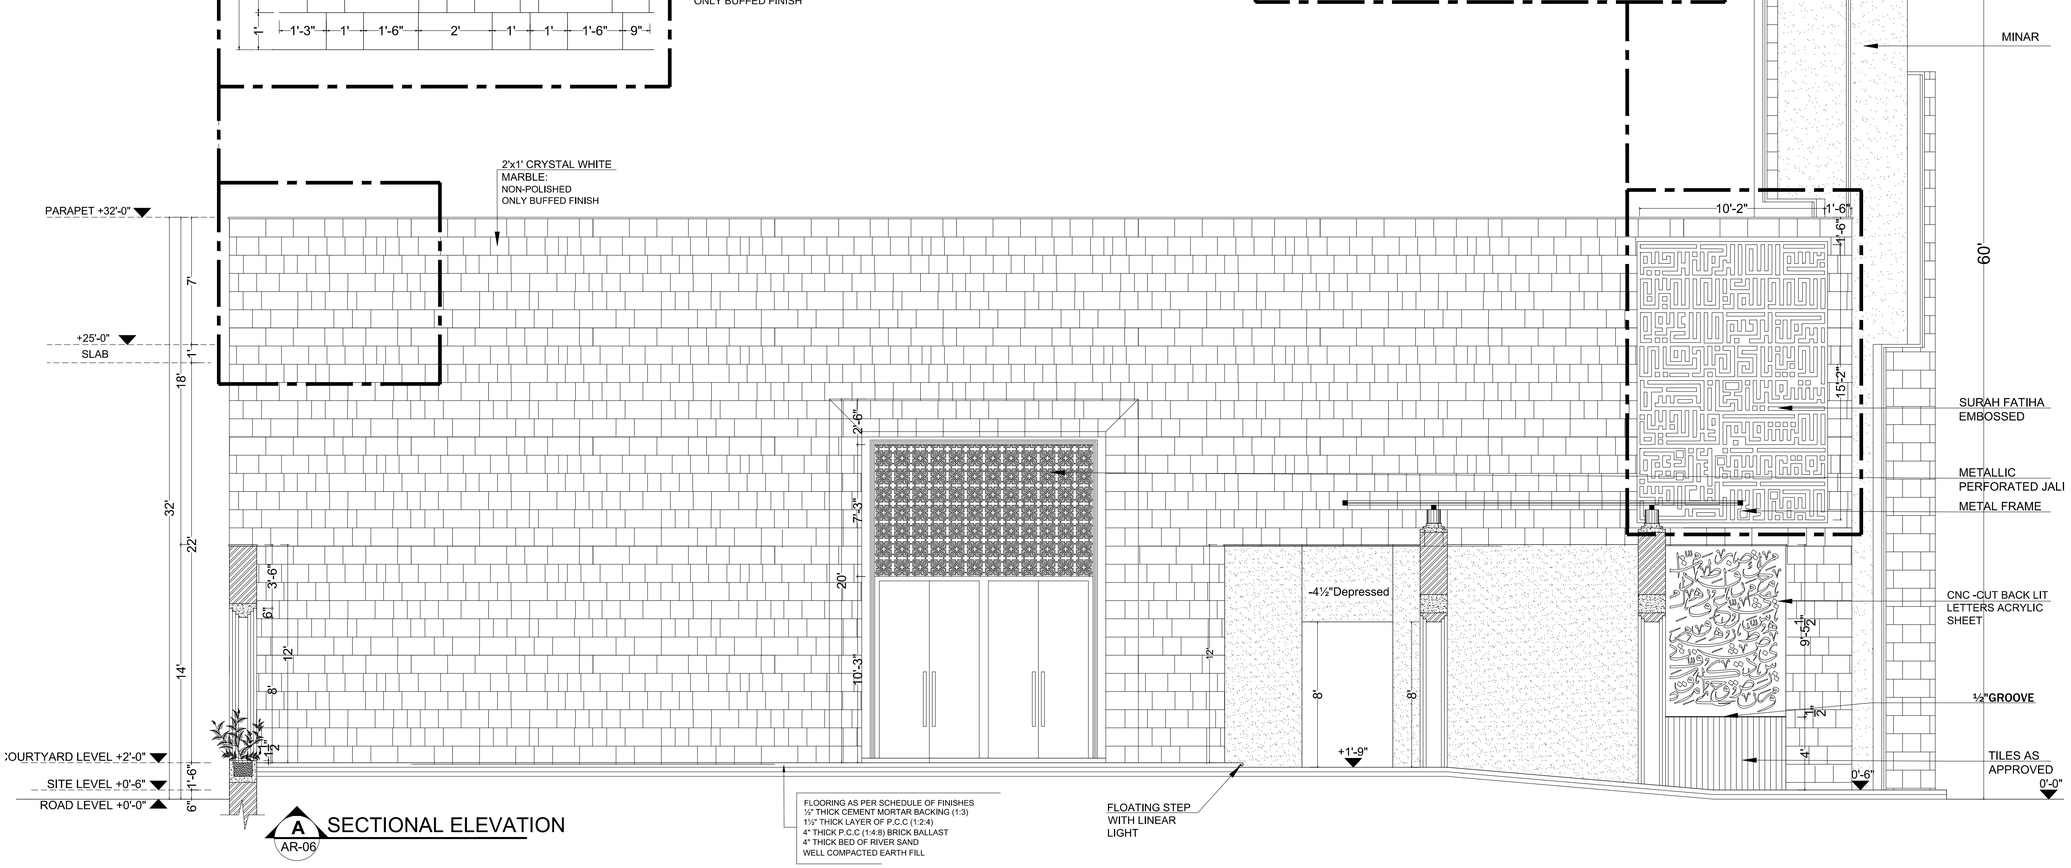

A AR-06 SECTIONAL ELEVATION

Building North:

Q N

Project Name & Address:

TARIQ MASJID

Client Name:

EASTERN HOUSING

Project number:	Drawing Number:
2024.09.0021	AR-10

Sheet Title:

SECTIONAL ELEVATION-A

Date Created:	Scale:
24-07- 2024	N.T.S

Design by :	Drawn by :	Check by :
ALI HAMZA	MONAM ALI	A.Ibrahim

GENERAL NOTES :

RECORD DRAWING

DATE	REV#	DESCRIPTION


KEY PLAN:


This drawing is to be read in conjunction with all related dwgs.
Do not scale from this drawing. All dimensions must be checked and verified on site before commencing any work or producing shop drawings. The originator should be notified immediately of any discrepancy.
This drawing is copyright and remains the property of AIA.

AHMED IBRAHIM ARCHITECTS

ARCHITECTURE | INTERIOR DESIGN | CONSTRUCTION
PLANNING | DESIGN | LANDSCAPE

288 G1 Johar town Lahore
aia.designteam@gmail.com

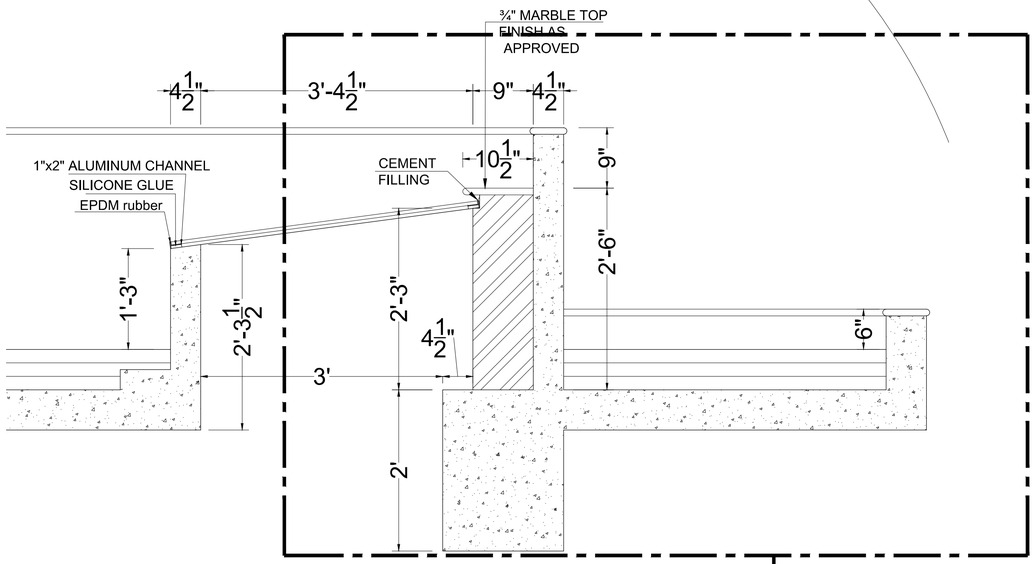

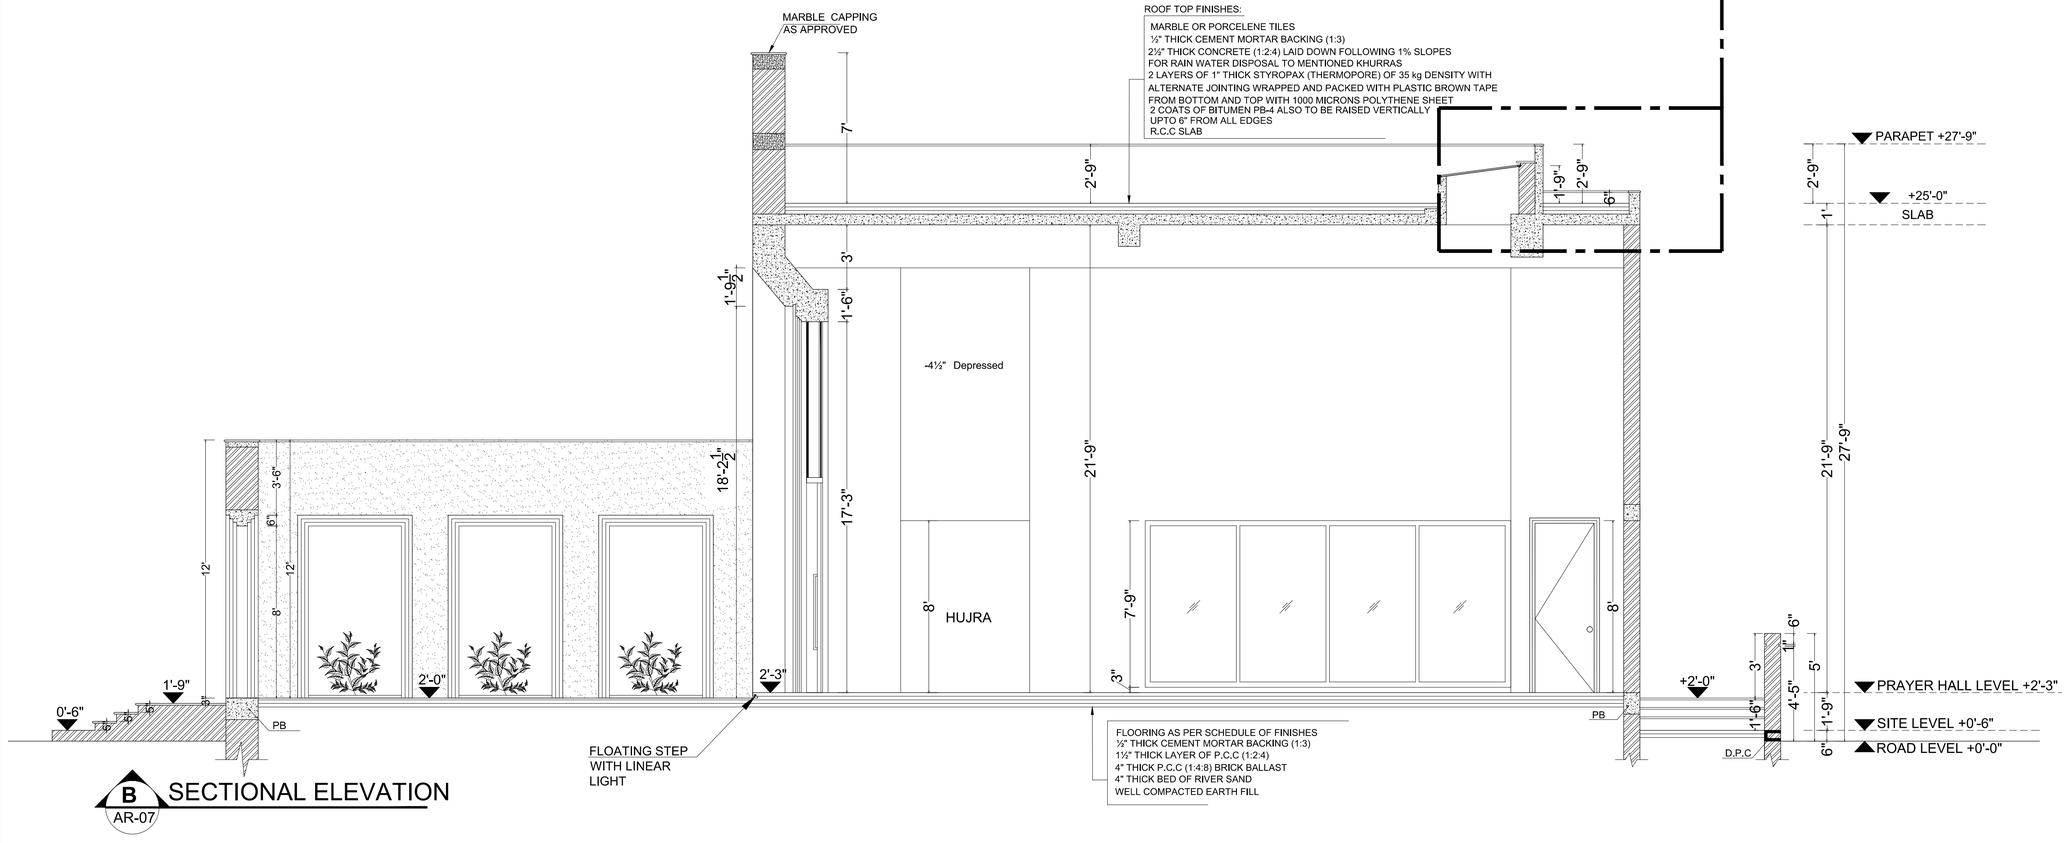

B AR-07 SECTIONAL ELEVATION

Building North:

Q N

Project Name & Address:

TARIQ MASJID

Client Name:

EASTERN HOUSING

Project number:	Drawing Number:
2024.09.0021	AR-11

Sheet Title:

SECTION -B

Date Created:	Scale:
24-07- 2024	N.T.S

Design by :	Drawn by :	Check by :
ALI HAMZA	MONAM ALI	A.Ibrahim

GENERAL NOTES :

RECORD DRAWING

DATE	REVI	DESCRIPTION


KEY PLAN:

This drawing is to be read in conjunction with all related dwgs. Do not scale from this drawing. All dimensions must be checked and verified on site before commencing any work or producing shop drawings. The originator should be notified immediately of any discrepancy.
This drawing is copyright and remains the property of AIA.

AHMED IBRAHIM ARCHITECTS

ARCHITECTURE | INTERIOR DESIGN | CONSTRUCTION
PLANNING | DESIGN | LANDSCAPE

288 G1 Johar town Lahore
aia.designteam@gmail.com

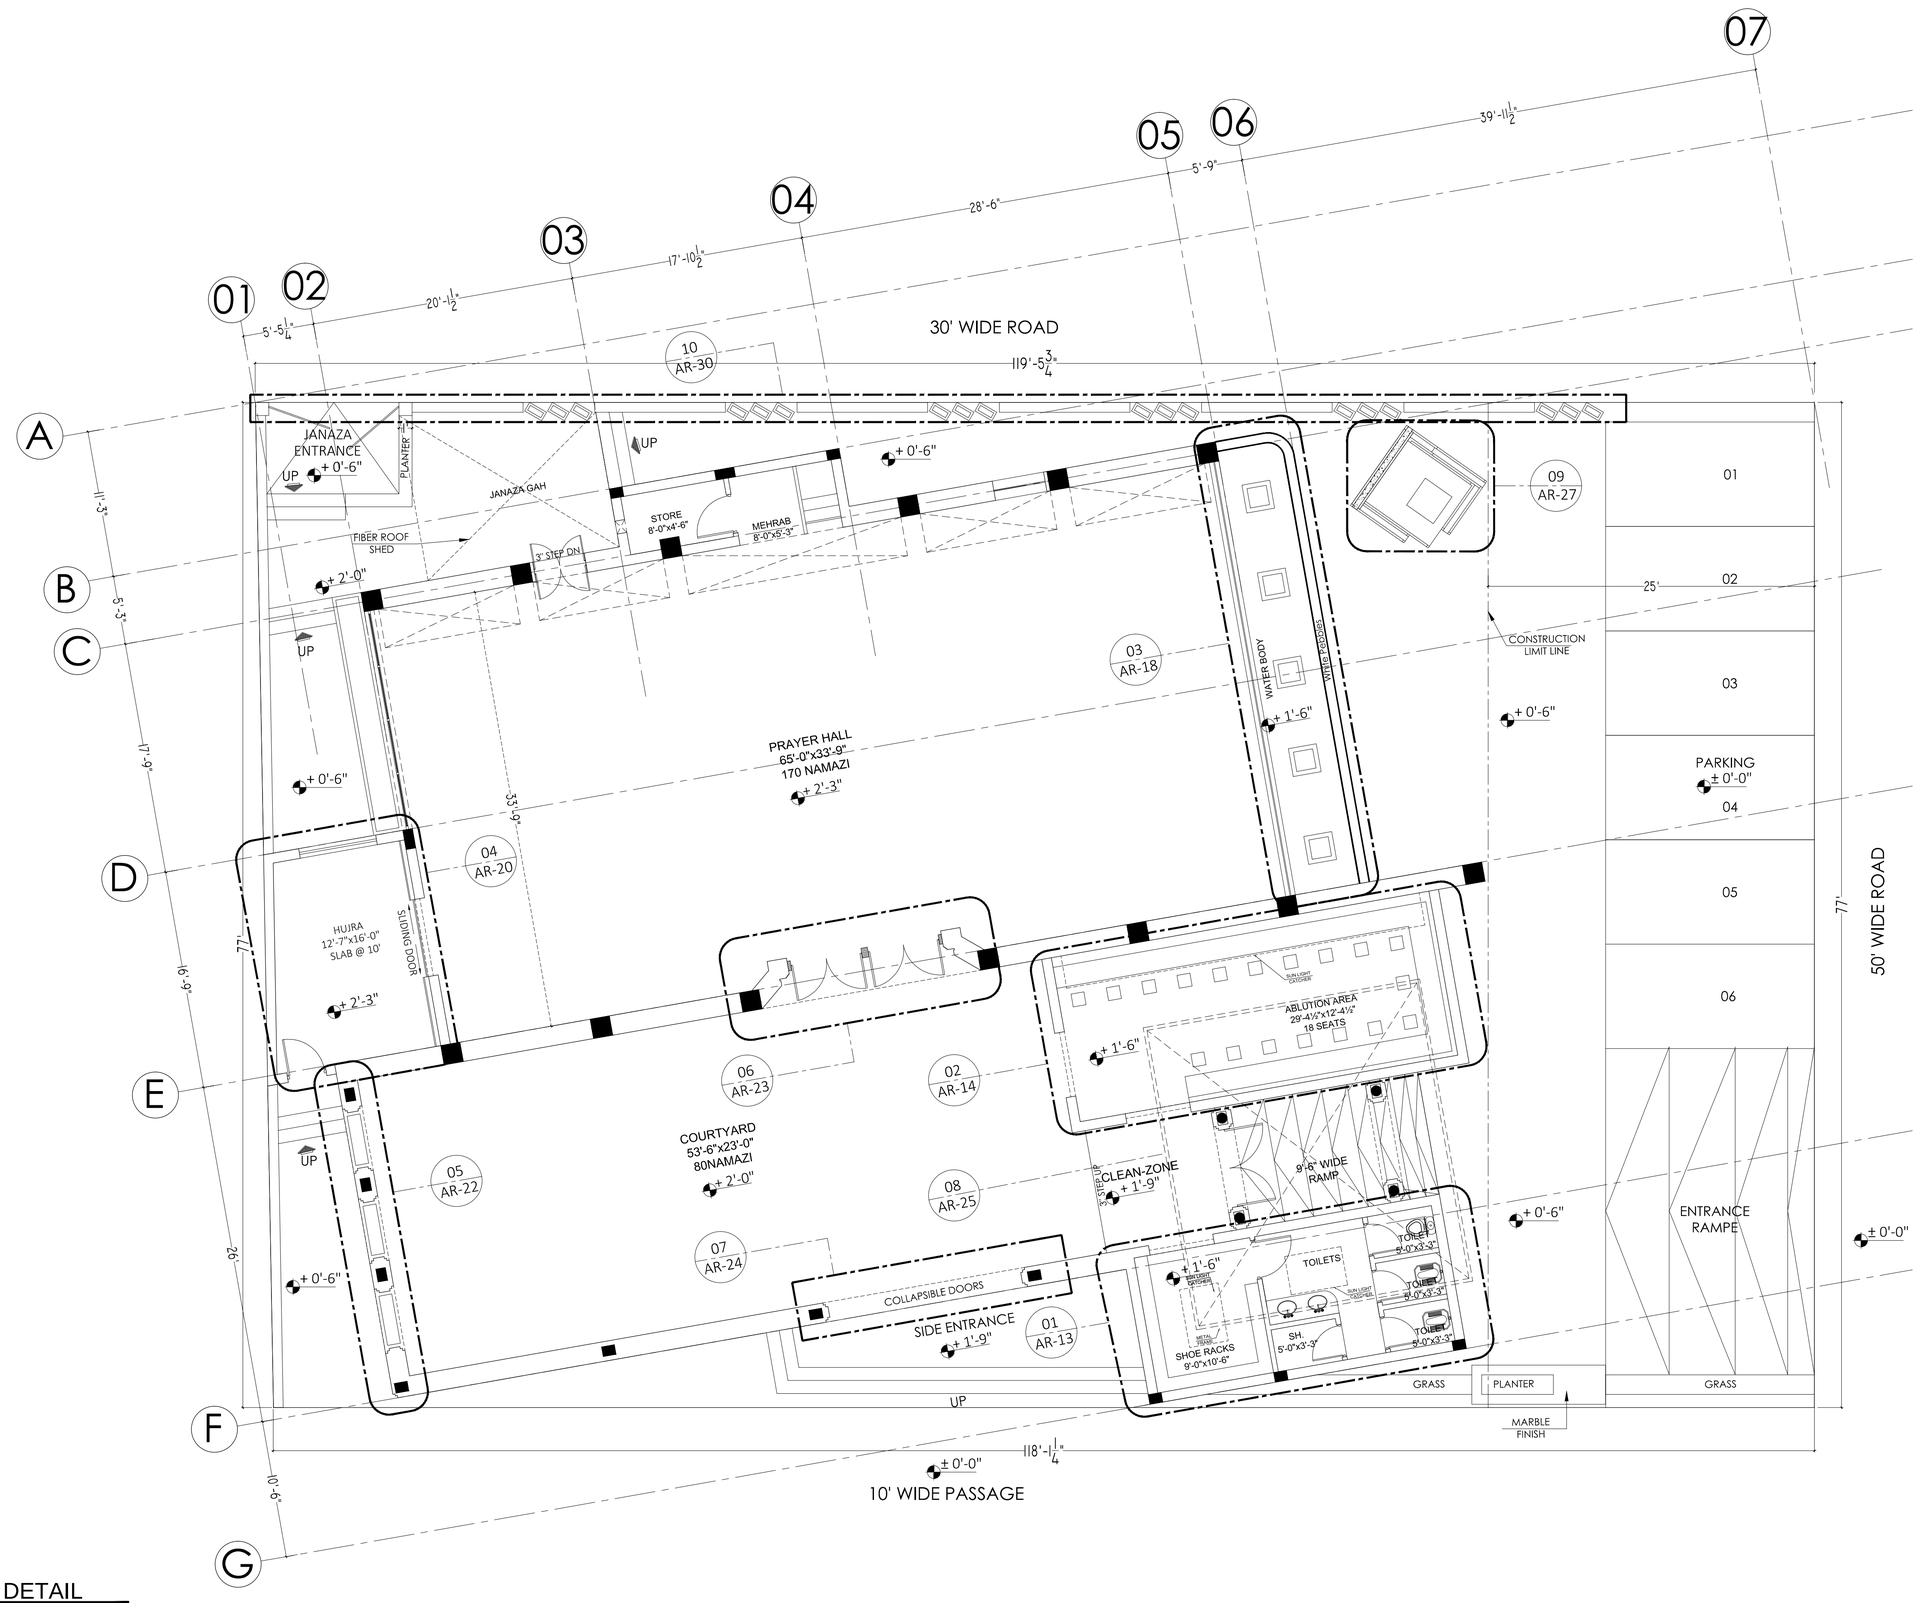

01 DETAIL MARKED PLAN

Building North:

Q N

Project Name & Address:

TARIQ MASJID

Client Name:

EASTERN HOUSING

Project number:	Drawing Number:
2024.09.0021	AR-12

Sheet Title: GROUND FLOOR DETAIL MARKED

Date Created:	Scale:
24-07- 2024	N.T.S

Design by :	Drawn by :	Check by :
ALI HAMZA	MONAM ALI	A.Ibrahim

GENERAL NOTES :

RECORD DRAWING

DATE	REVI	DESCRIPTION


KEY PLAN:

This drawing is to be read in conjunction with all related dwgs. Do not scale from this drawing. All dimensions must be checked and verified on site before commencing any work or producing shop drawings. The originator should be notified immediately of any discrepancy.
This drawing is copyright and remains the property of AIA.

AHMED IBRAHIM ARCHITECTS


ARCHITECTURE | INTERIOR DESIGN | CONSTRUCTION
PLANNING | DESIGN | LANDSCAPE


288 G1 Johar town Lahore
aia.designteam@gmail.com

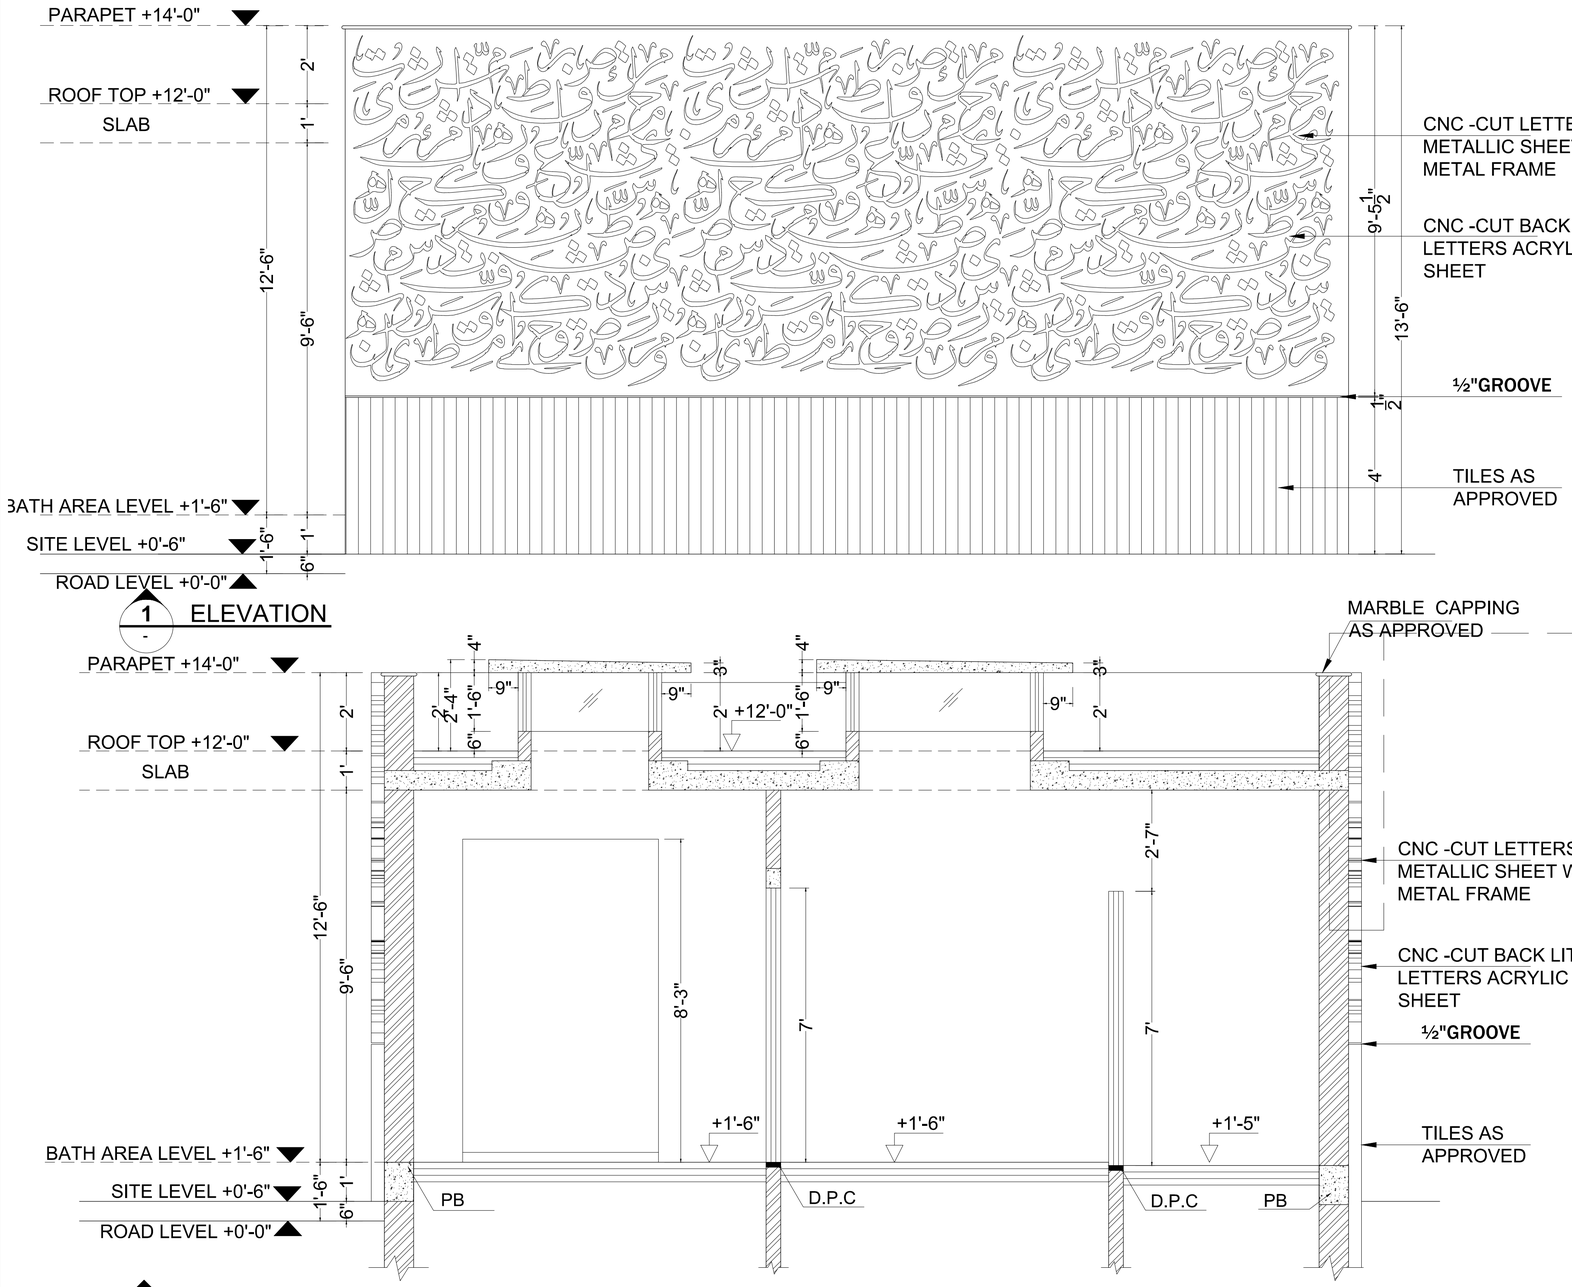

1 ELEVATION
-

1 SECTION -1
-

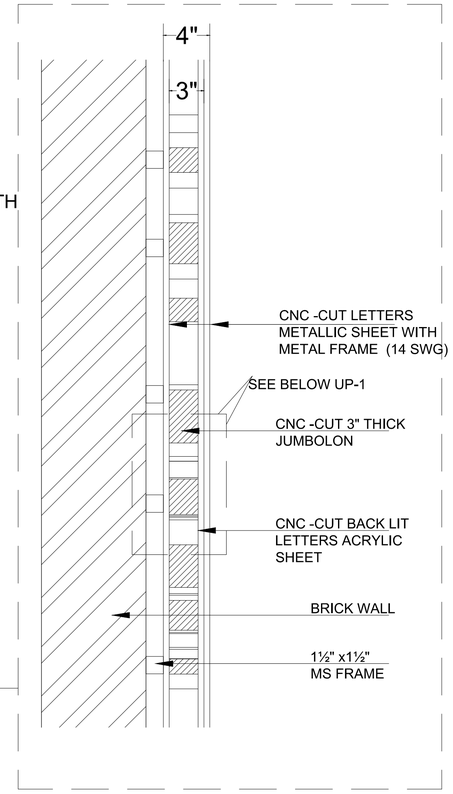

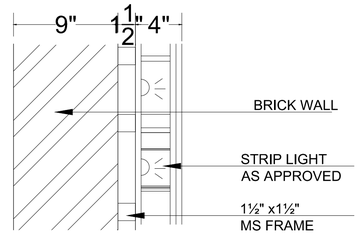

BELOW UP-1

DETAIL-1

Building North:

Q N

Project Name & Address:

TARIQ MASJID

Client Name:

EASTERN HOUSING

Project number:	Drawing Number:
2024.09.0021	AR-14

Sheet Title:

DETAIL-1

Date Created:	Scale:
24-07- 2024	N.T.S

Design by :	Drawn by :	Check by :
ALI HAMZA	MONAM ALI	A.Ibrahim

GENERAL NOTES :

RECORD DRAWING

DATE	REV#	DESCRIPTION


KEY PLAN:

This drawing is to be read in conjunction with all related dwgs. Do not scale from this drawing. All dimensions must be checked and verified on site before commencing any work or producing shop drawings. The originator should be notified immediately of any discrepancy.
This drawing is copyright and remains the property of AIA.


AHMED IBRAHIM ARCHITECTS

ARCHITECTURE | INTERIOR DESIGN | CONSTRUCTION
PLANNING | DESIGN | LANDSCAPE

288 G1 Johar town Lahore
aia.designteam@gmail.com

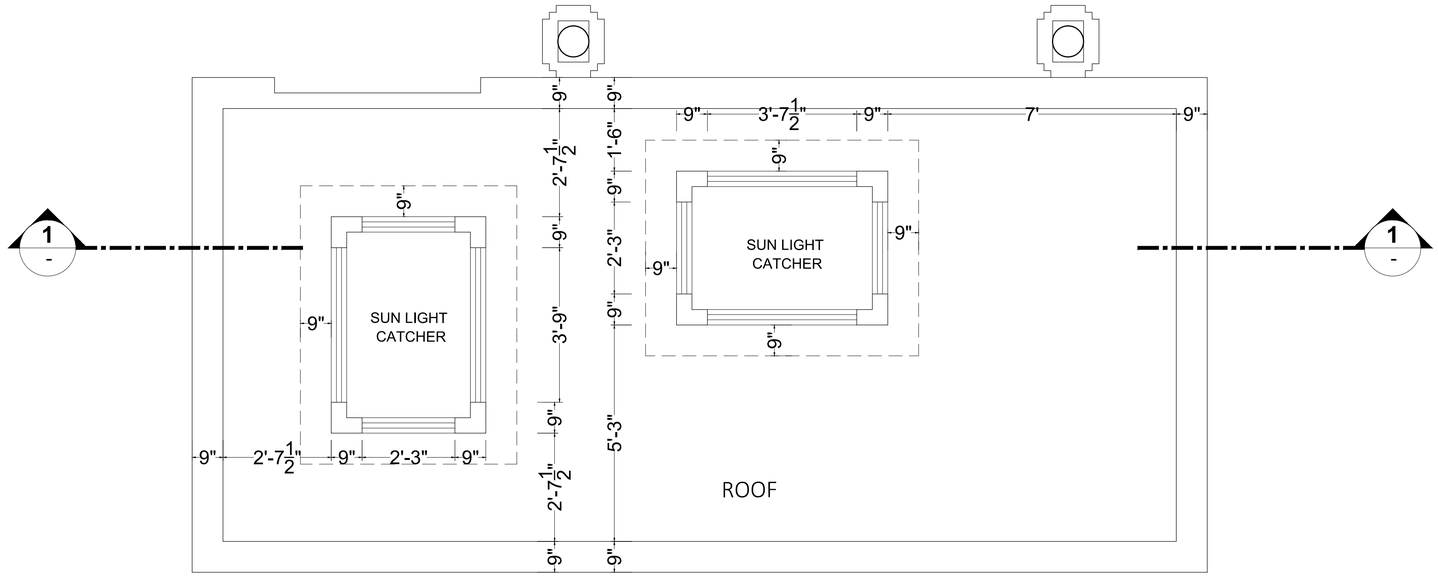

2 - ROOF PLAN
DETAIL-1

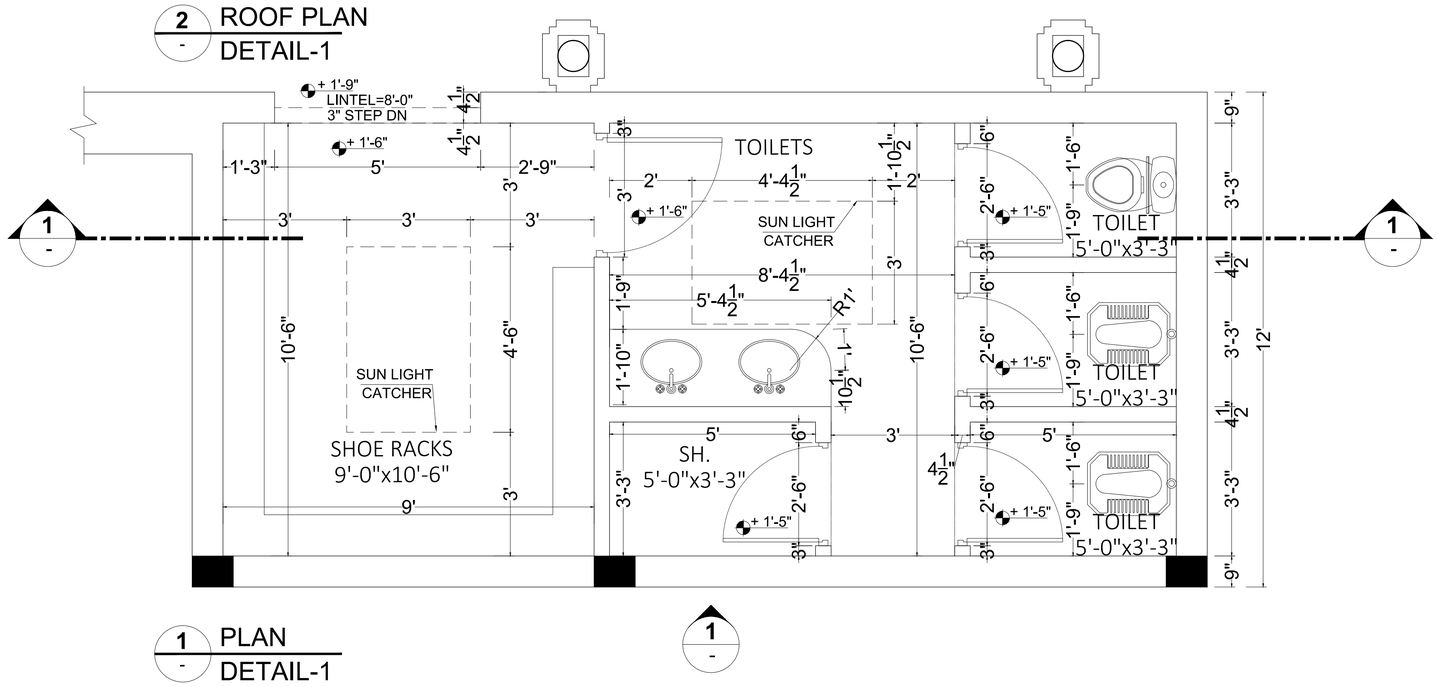

1 - PLAN
DETAIL-1

DETAIL-1

Building North:

Project Name & Address:

TARIQ MASJID

Client Name:

EASTERN HOUSING

Project number:	Drawing Number:
2024.09.0021	AR-13

Sheet Title:

DETAIL-1

Date Created:	Scale:
24-07- 2024	N.T.S

Design by :	Drawn by :	Check by :
ALI HAMZA	MONAM ALI	A.Ibrahim

GENERAL NOTES :

RECORD DRAWING

DATE	REVI	DESCRIPTION


KEY PLAN:


This drawing is to be read in conjunction with all related dwgs. Do not scale from this drawing. All dimensions must be checked and verified on site before commencing any work or producing shop drawings. The originator should be notified immediately of any discrepancy.
This drawing is copyright and remains the property of AIA.

AHMED IBRAHIM ARCHITECTS


ARCHITECTURE | INTERIOR DESIGN | CONSTRUCTION
PLANNING | DESIGN | LANDSCAPE

288 G1 Johar town Lahore
aia.designteam@gmail.com

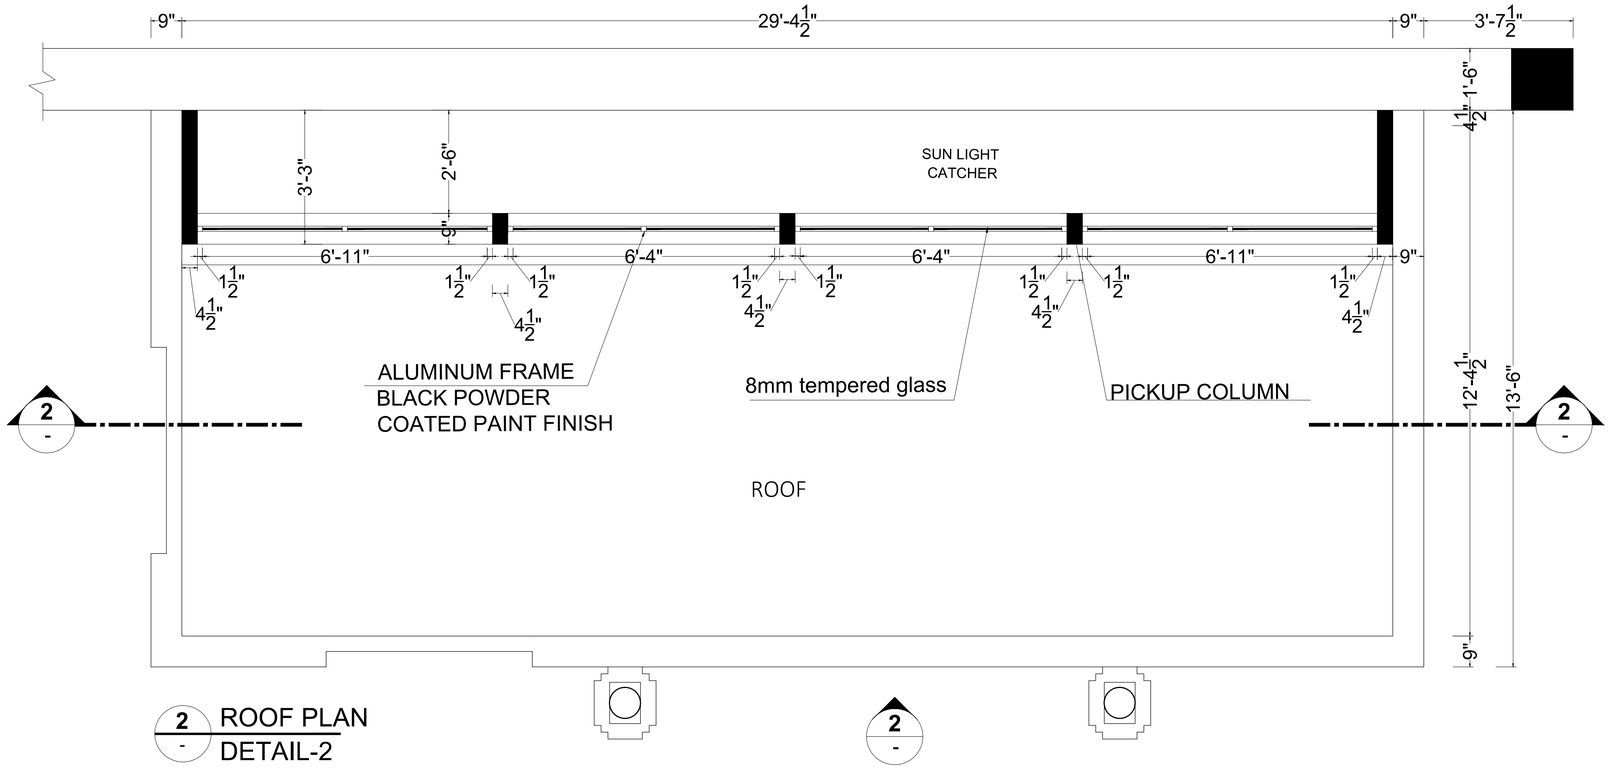

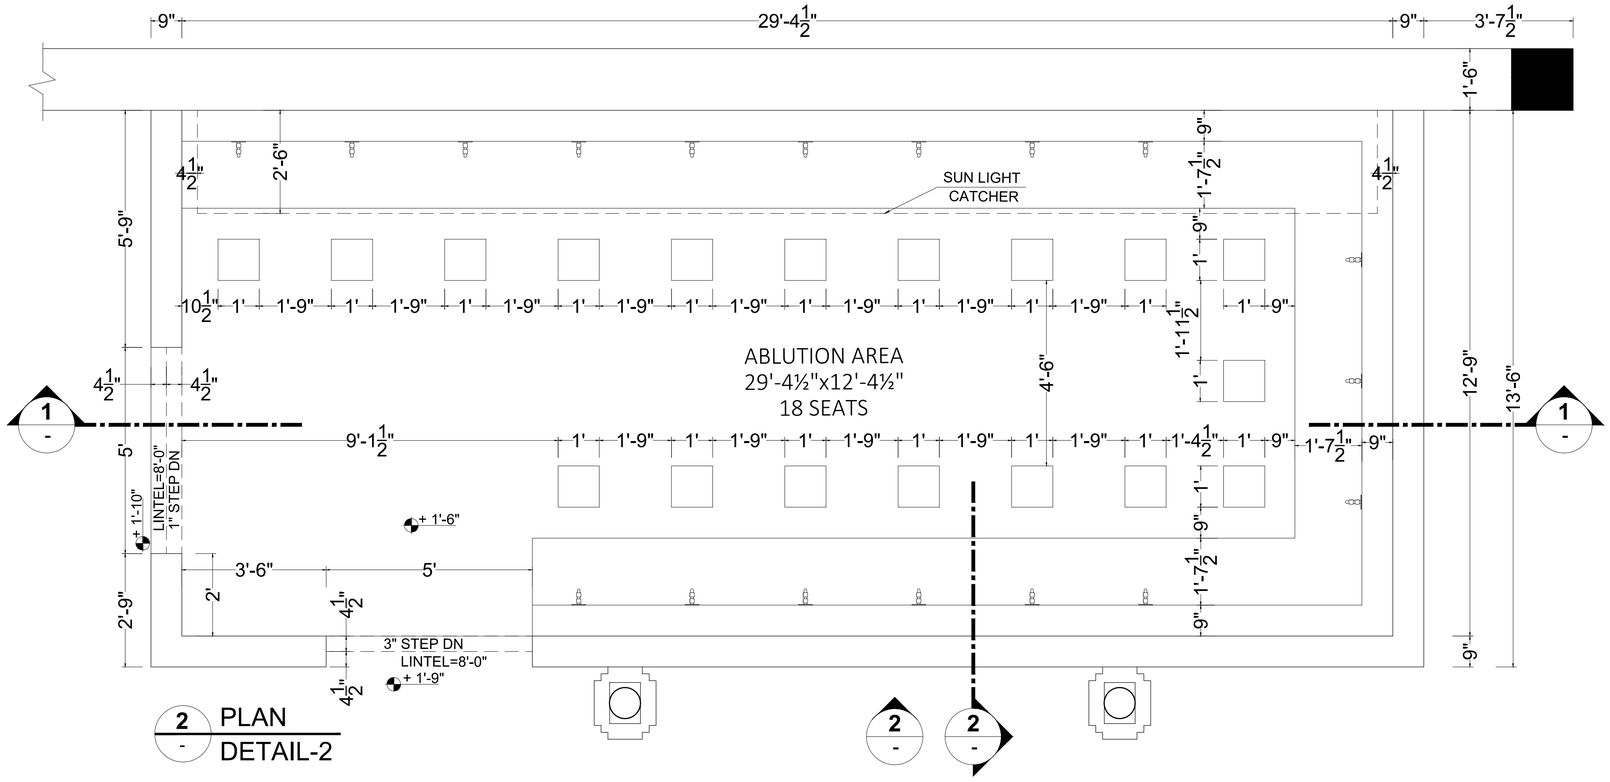

Building North:

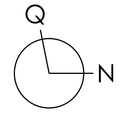

Project Name & Address:

TARIQ MASJID

Client Name:

EASTERN HOUSING

Project number:	Drawing Number:
2024.09.0021	AR-15

Sheet Title:

DETAIL-2

Date Created:	Scale:
24-07- 2024	N.T.S

Design by :	Drawn by :	Check by :
ALI HAMZA	MONAM ALI	A.Ibrahim

GENERAL NOTES :

RECORD DRAWING

DATE	REV#	DESCRIPTION


KEY PLAN:

This drawing is to be read in conjunction with all related dwgs. Do not scale from this drawing. All dimensions must be checked and verified on site before commencing any work or producing shop drawings. The originator should be notified immediately of any discrepancy.
This drawing is copyright and remains the property of AIA.


AHMED IBRAHIM ARCHITECTS

ARCHITECTURE | INTERIOR DESIGN | CONSTRUCTION
PLANNING | DESIGN | LANDSCAPE

288 G1 Johar town Lahore
aia.designteam@gmail.com

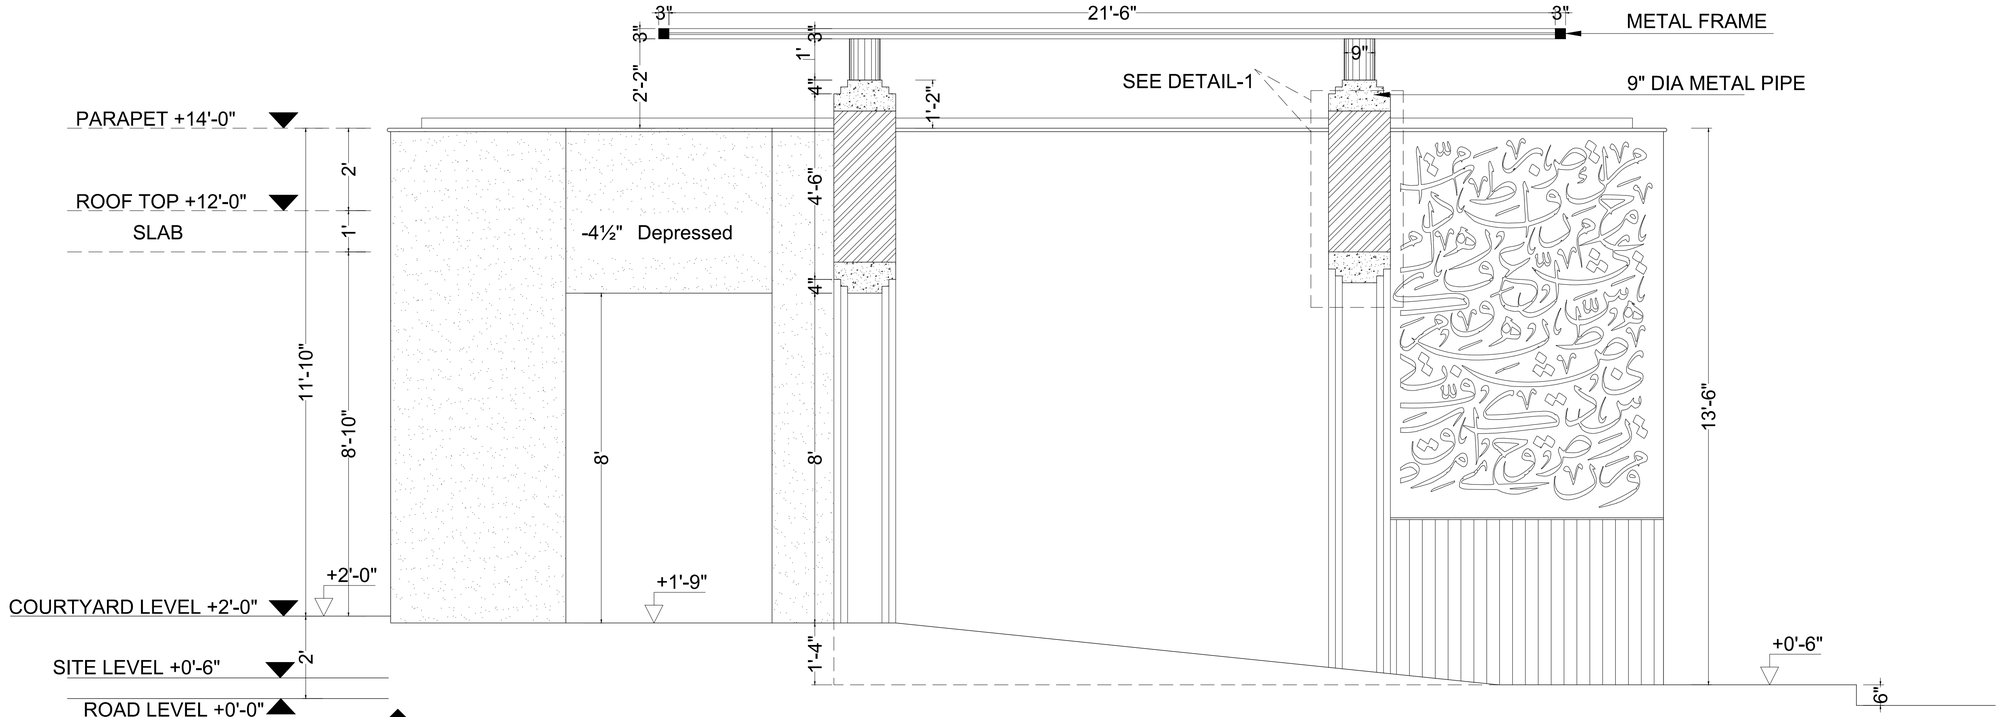

2 - SECTIONAL ELEVATION

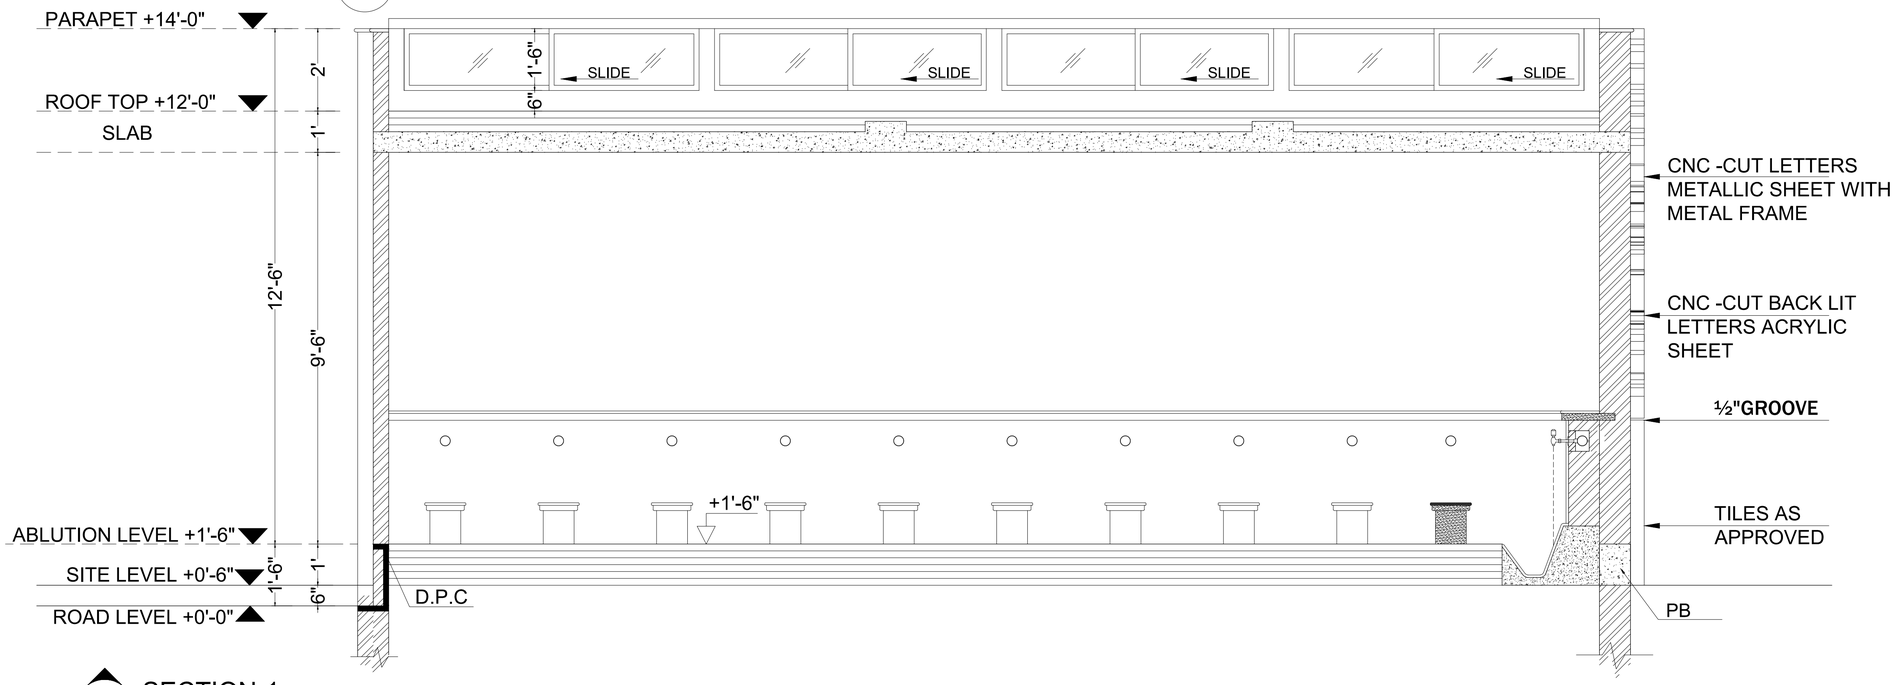

1 - SECTION-1

DETAIL-2

Building North:

Q

N

Project Name & Address:

TARIQ MASJID

Client Name:

EASTERN HOUSING

Project number:	Drawing Number:
2024.09.0021	AR-16

Sheet Title:

DETAIL-2

Date Created:	Scale:
24-07- 2024	N.T.S

Design by :	Drawn by :	Check by :
ALI HAMZA	MONAM ALI	A.Ibrahim

GENERAL NOTES :

RECORD DRAWING

DATE	REV#	DESCRIPTION


KEY PLAN:

This drawing is to be read in conjunction with all related dwgs. Do not scale from this drawing. All dimensions must be checked and verified on site before commencing any work or producing shop drawings. The originator should be notified immediately of any discrepancy.
This drawing is copyright and remains the property of AIA.


AHMED IBRAHIM ARCHITECTS

ARCHITECTURE | INTERIOR DESIGN | CONSTRUCTION
PLANNING | DESIGN | LANDSCAPE

288 G1 Johar town Lahore
aia.designteam@gmail.com

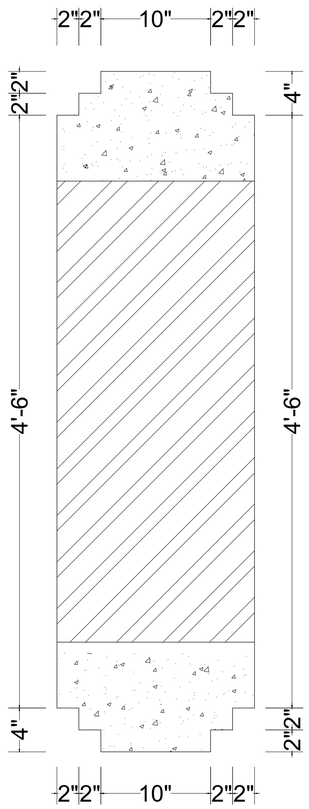

DETAIL-1

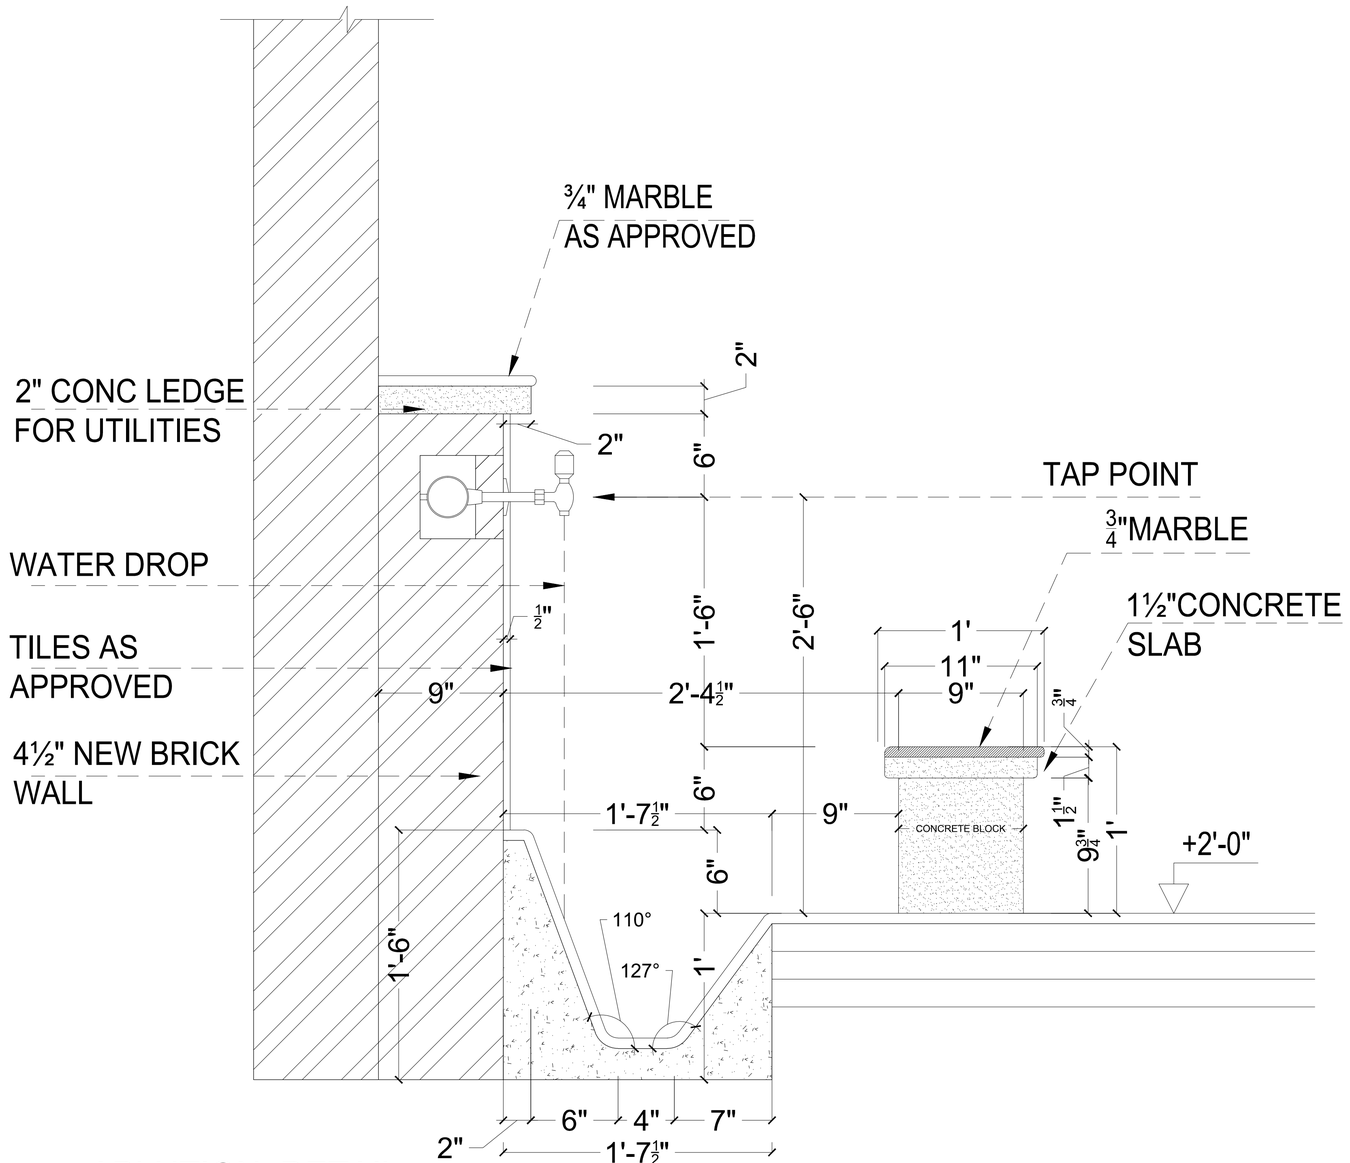

ABLUTION DETAIL

DETAIL-2

Building North:

Q
N

Project Name & Address:

TARIQ MASJID

Client Name:

EASTERN HOUSING

Project number:	Drawing Number:
2024.09.0021	AR-15

Sheet Title:

DETAIL-17

Date Created:	Scale:
24-07- 2024	N.T.S

Design by :	Drawn by :	Check by :
ALI HAMZA	MONAM ALI	A.Ibrahim

GENERAL NOTES :

RECORD DRAWING

DATE	REVI	DESCRIPTION


KEY PLAN:


This drawing is to be read in conjunction with all related dwgs.
Do not scale from this drawing. All dimensions must be checked and verified on site before commencing any work or producing shop drawings. The originator should be notified immediately of any discrepancy.
This drawing is copyright and remains the property of AIA.

AHMED IBRAHIM ARCHITECTS

ARCHITECTURE | INTERIOR DESIGN | CONSTRUCTION
PLANNING | DESIGN | LANDSCAPE

288 G1 Johar town Lahore
aia.designteam@gmail.com

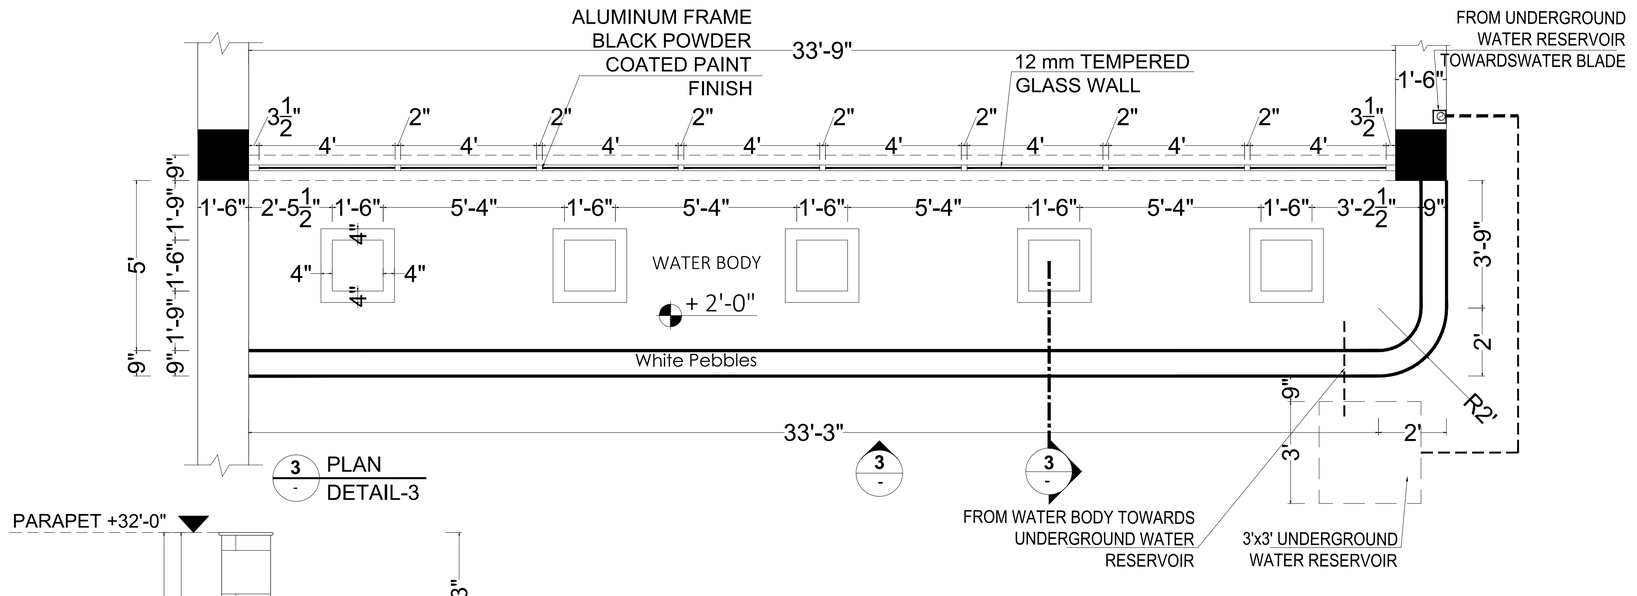

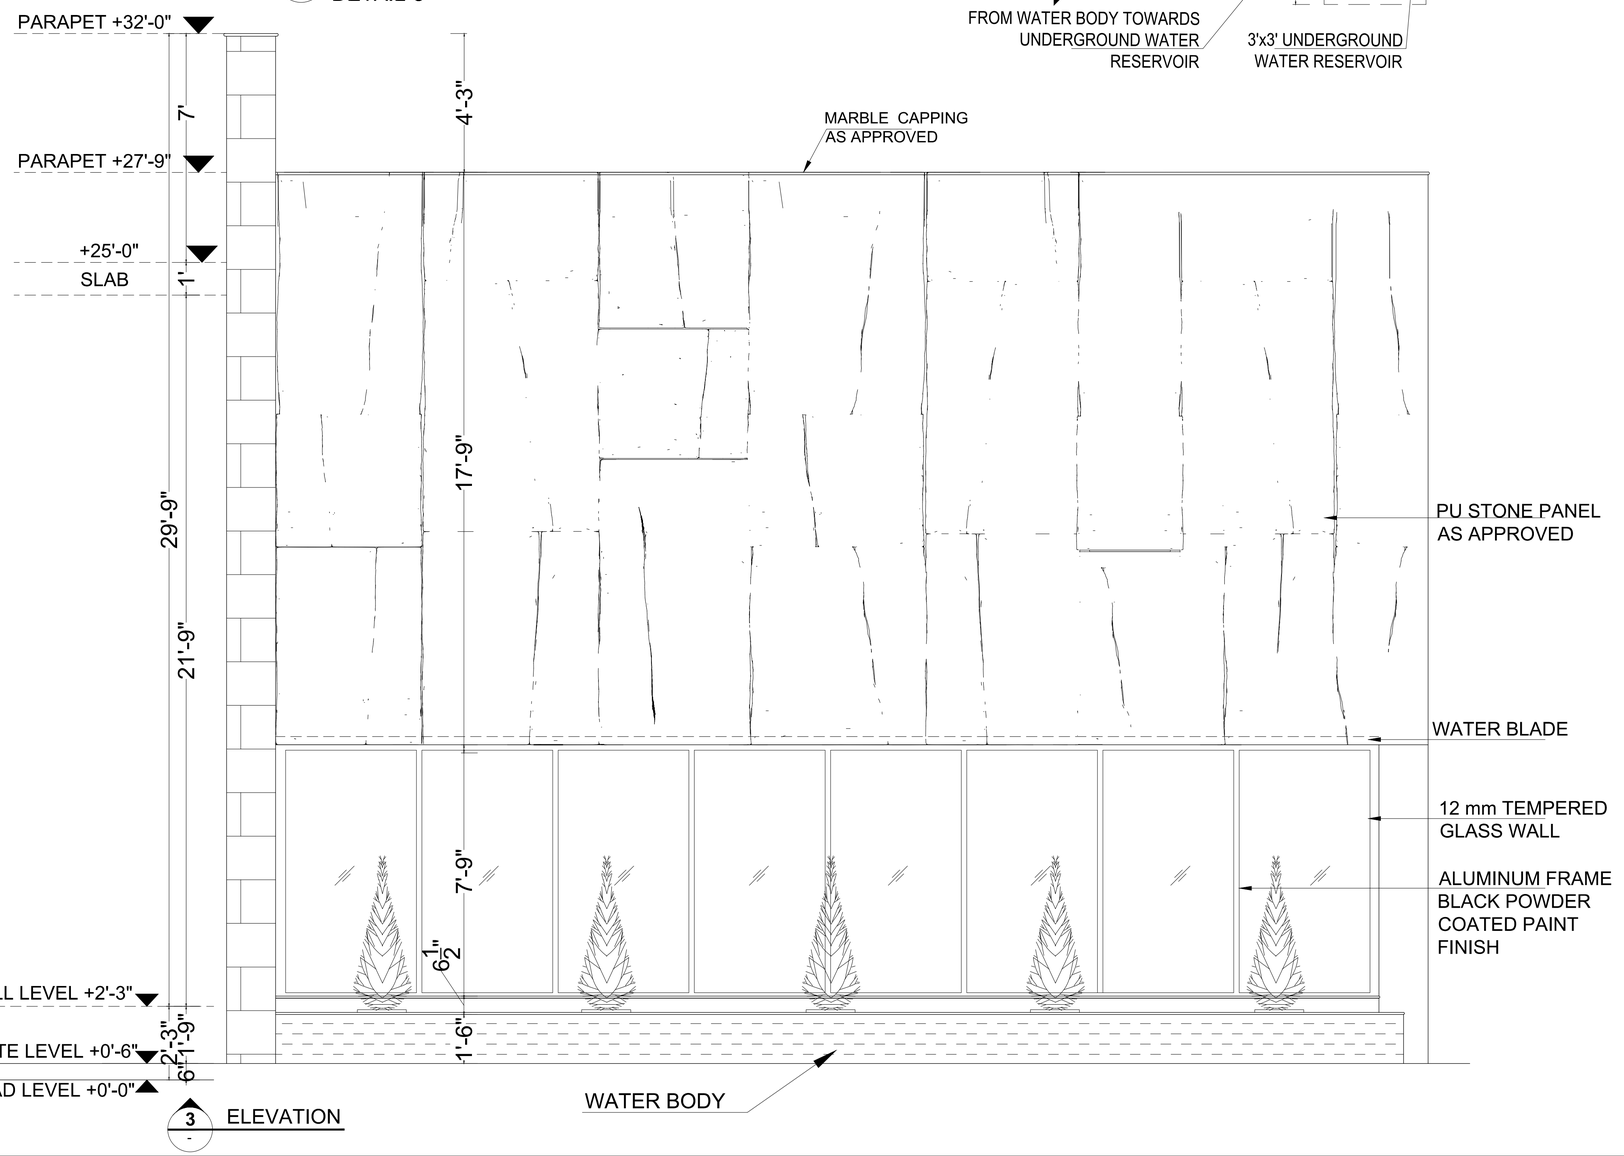

DETAIL-3

3 - ELEVATION

Building North:

Project Name & Address:

TARIQ MASJID

Client Name:

EASTERN HOUSING

Project number: 2024.09.0021

Drawing Number: AR-18

Sheet Title: DETAIL-3

Date Created: 24-07- 2024

Scale: N.T.S

Design by : ALI HAMZA

Drawn by : MONAM ALI

Check by : A.Ibrahim

GENERAL NOTES :

RECORD DRAWING

DATE	REV#	DESCRIPTION


KEY PLAN:

This drawing is to be read in conjunction with all related dwgs. Do not scale from this drawing. All dimensions must be checked and verified on site before commencing any work or producing shop drawings. The originator should be notified immediately of any discrepancy.
This drawing is copyright and remains the property of AIA.

AHMED IBRAHIM ARCHITECTS

ARCHITECTURE | INTERIOR DESIGN | CONSTRUCTION
PLANNING | DESIGN | LANDSCAPE

288 G1 Johar town Lahore
aia.designteam@gmail.com

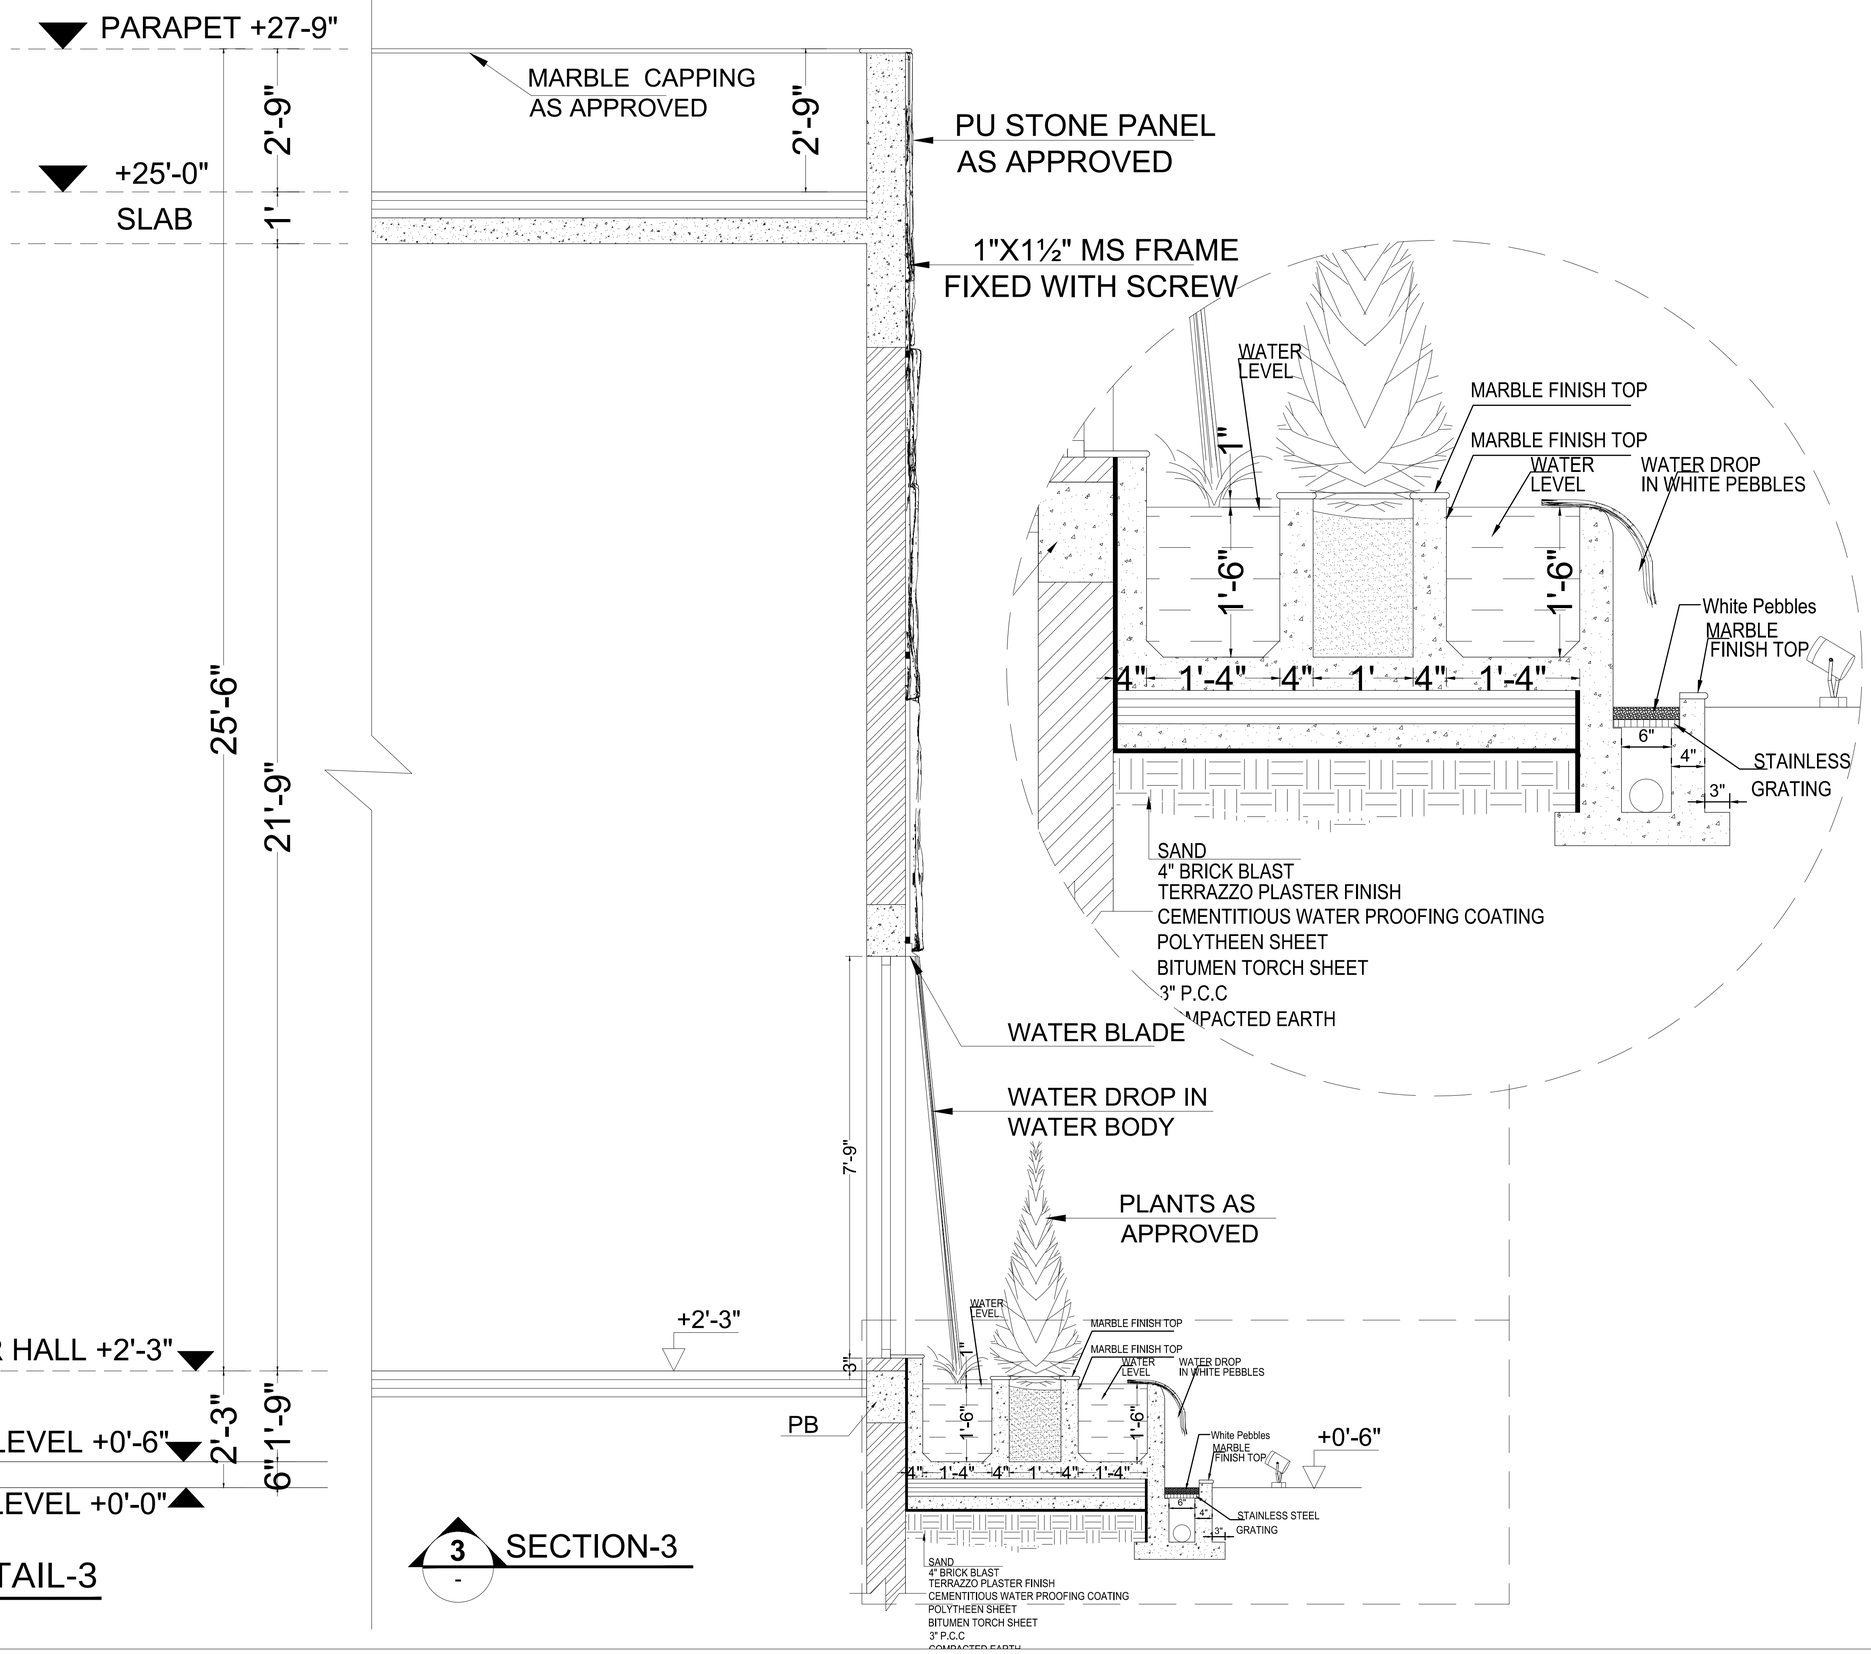

Building North:

Project Name & Address:

TARIQ MASJID

Client Name:

EASTERN HOUSING

Project number:	Drawing Number:
2024.09.0021	AR-19

Sheet Title:

DETAIL-3

Date Created:	Scale:
24-07- 2024	N.T.S

Design by :	Drawn by :	Check by :
ALI HAMZA	MONAM ALI	A.Ibrahim

GENERAL NOTES :

RECORD DRAWING

DATE	REV#	DESCRIPTION


KEY PLAN:

This drawing is to be read in conjunction with all related dwgs.
Do not scale from this drawing. All dimensions must be checked and verified on site before commencing any work or producing shop drawings. The originator should be notified immediately of any discrepancy.
This drawing is copyright and remains the property of AIA.

AHMED IBRAHIM ARCHITECTS

ARCHITECTURE | INTERIOR DESIGN | CONSTRUCTION
PLANNING | DESIGN | LANDSCAPE

288 G1 Johar town Lahore
aia.designteam@gmail.com

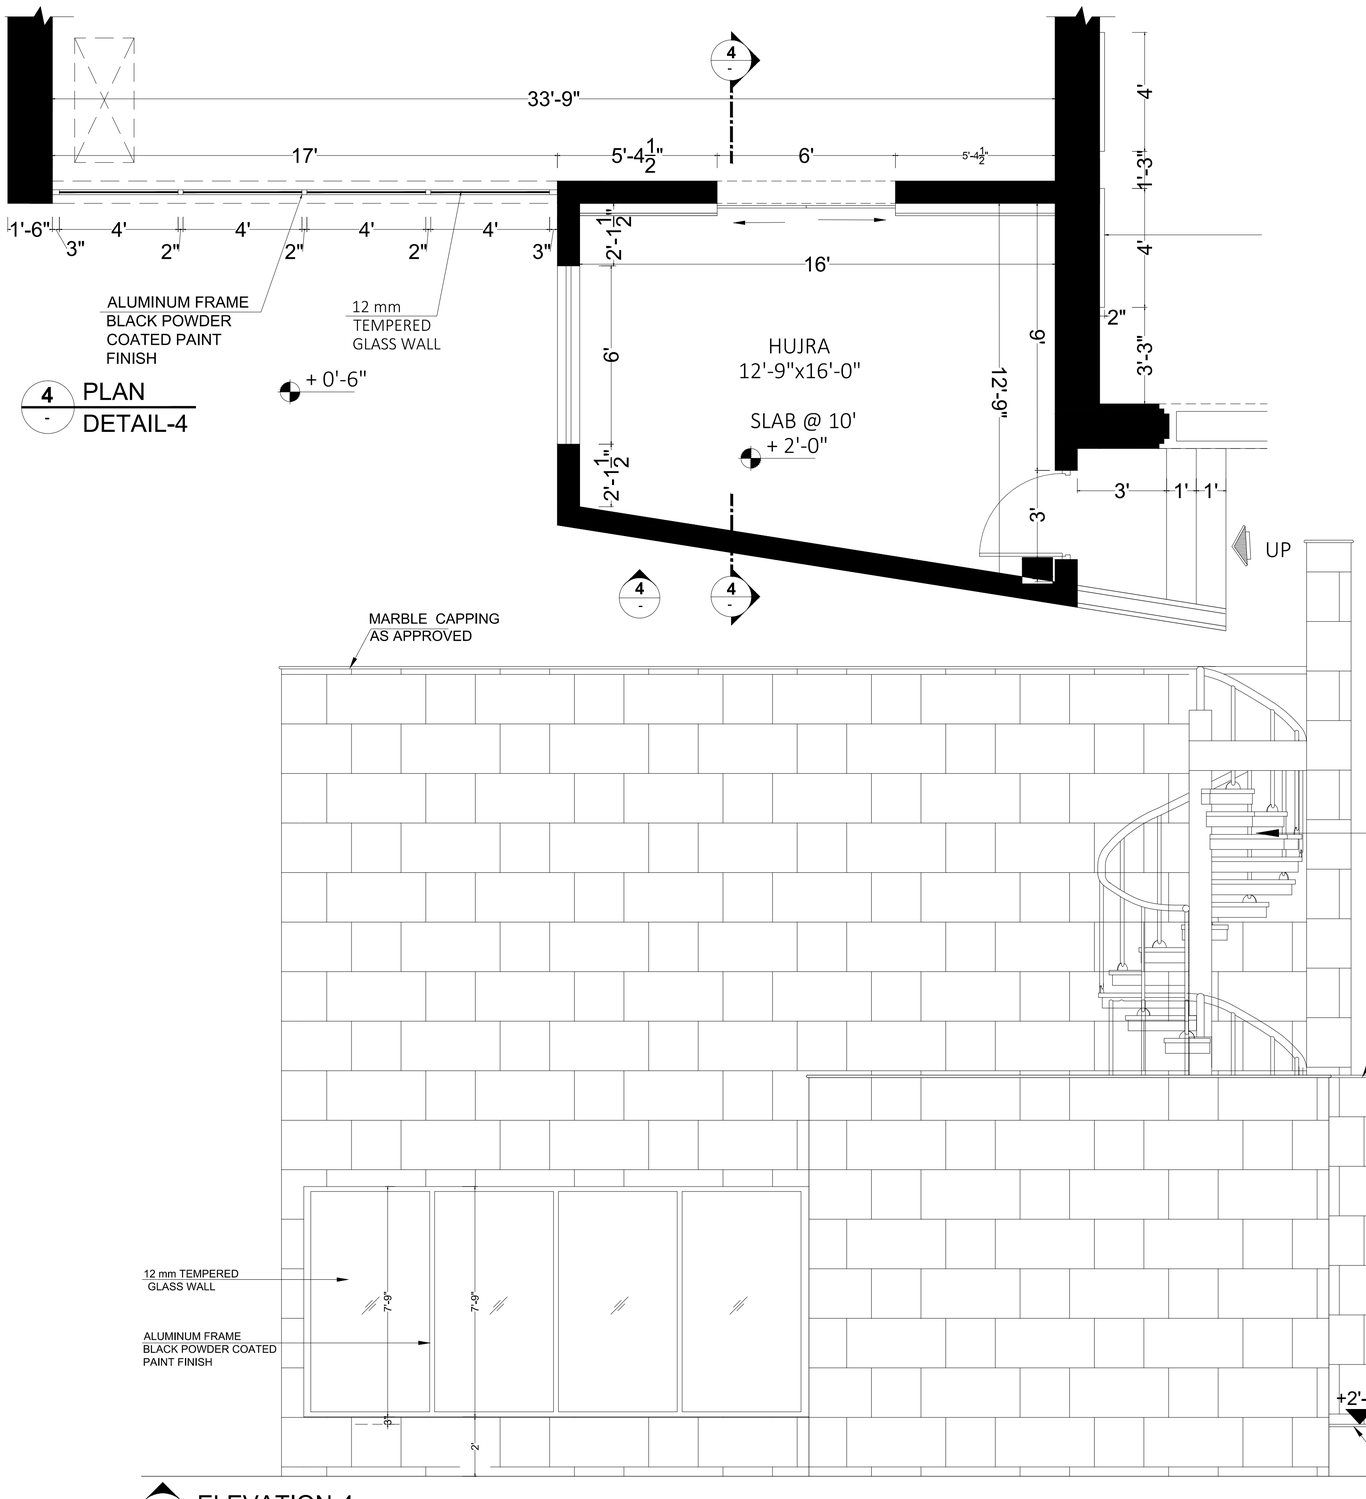

DETAIL-4

Building North:

Q

N

Project Name & Address:

TARIQ MASJID

Client Name:

EASTERN HOUSING

Project number:	Drawing Number:
2024.09.0021	AR-20

Sheet Title: DETAIL-4

Date Created:	Scale:
24-07- 2024	N.T.S

Design by :	Drawn by :	Check by :
ALI HAMZA	MONAM ALI	A.Ibrahim

GENERAL NOTES :

RECORD DRAWING

DATE	REV#	DESCRIPTION


KEY PLAN:

This drawing is to be read in conjunction with all related dwgs. Do not scale from this drawing. All dimensions must be checked and verified on site before commencing any work or producing shop drawings. The originator should be notified immediately of any discrepancy.
This drawing is copyright and remains the property of AIA.

AHMED IBRAHIM ARCHITECTS

ARCHITECTURE | INTERIOR DESIGN | CONSTRUCTION
PLANNING | DESIGN | LANDSCAPE

288 G1 Johar town Lahore
aia.designteam@gmail.com

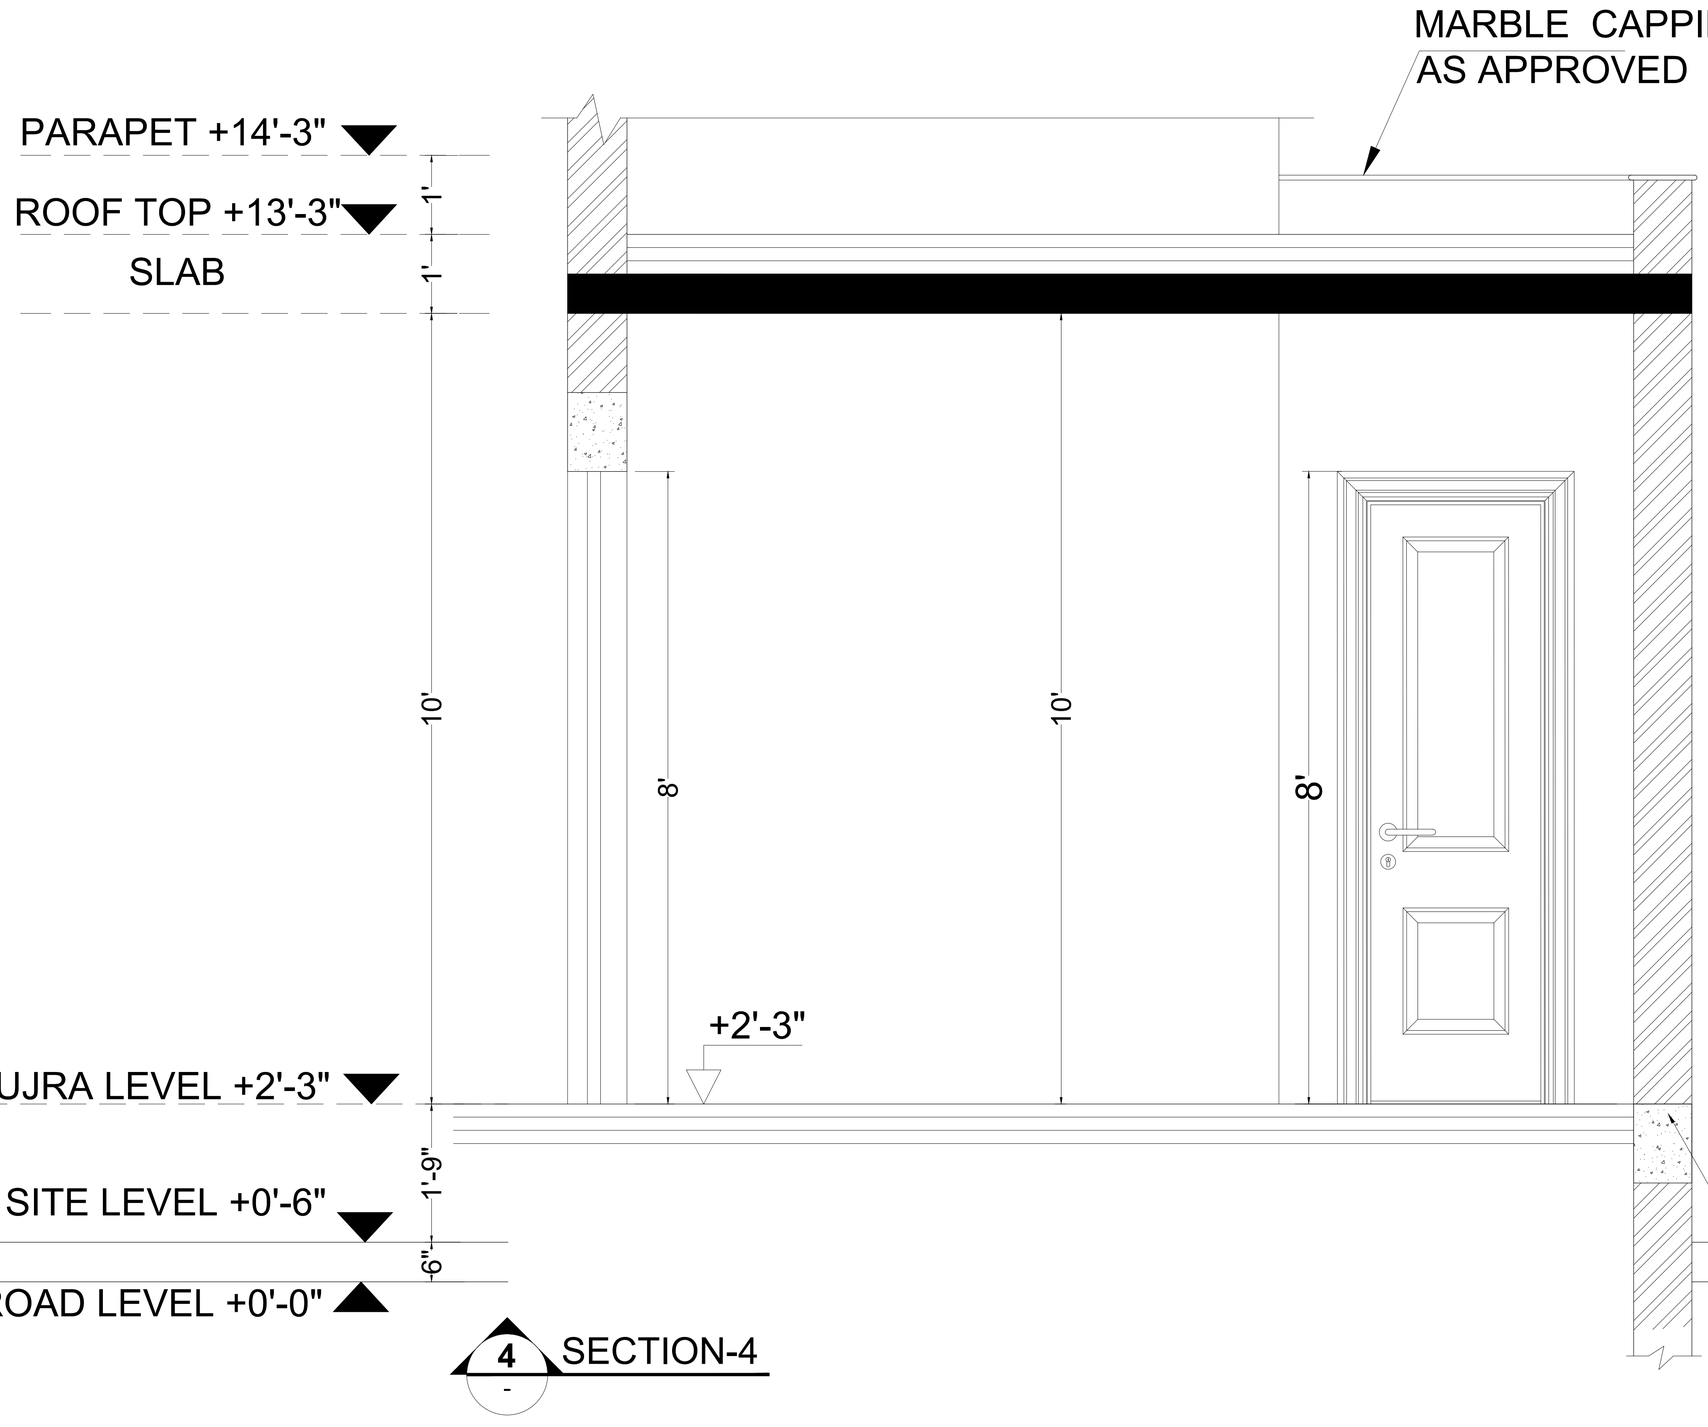

4 SECTION-4

DETAIL-4

Building North:

Q N

Project Name & Address:

TARIQ MASJID

Client Name:

EASTERN HOUSING

Project number:	Drawing Number:
2024.09.0021	AR-21

Sheet Title:

DETAIL-4

Date Created:	Scale:
24-07- 2024	N.T.S

Design by :	Drawn by :	Check by :
ALI HAMZA	MONAM ALI	A.Ibrahim

GENERAL NOTES :

RECORD DRAWING

DATE	REVI	DESCRIPTION


KEY PLAN:


This drawing is to be read in conjunction with all related dwgs. Do not scale from this drawing. All dimensions must be checked and verified on site before commencing any work or producing shop drawings. The originator should be notified immediately of any discrepancy.
This drawing is copyright and remains the property of AIA.

AHMED IBRAHIM ARCHITECTS


ARCHITECTURE | INTERIOR DESIGN | CONSTRUCTION
PLANNING | DESIGN | LANDSCAPE


288 G1 Johar town Lahore
aia.designteam@gmail.com

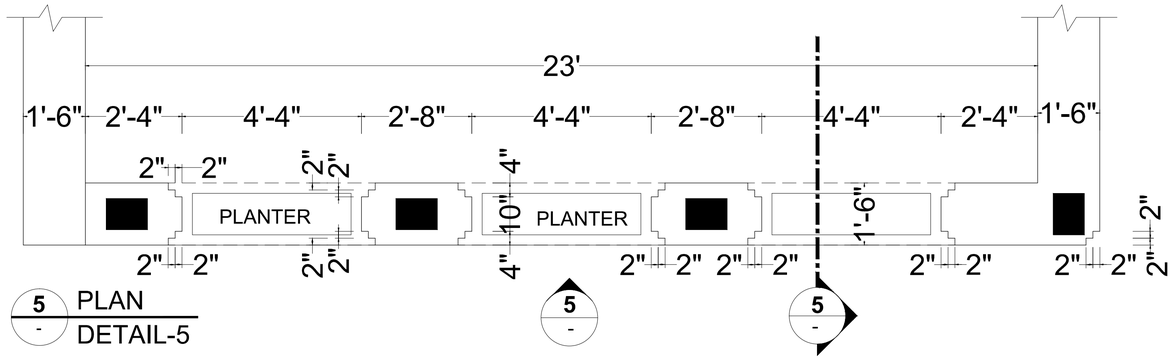

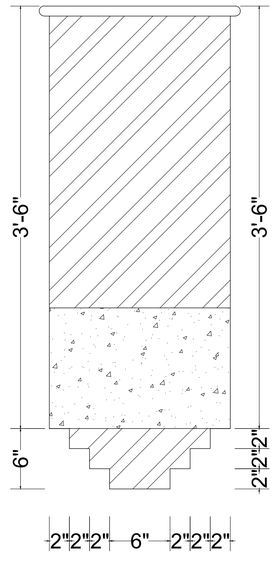

DETAIL-1

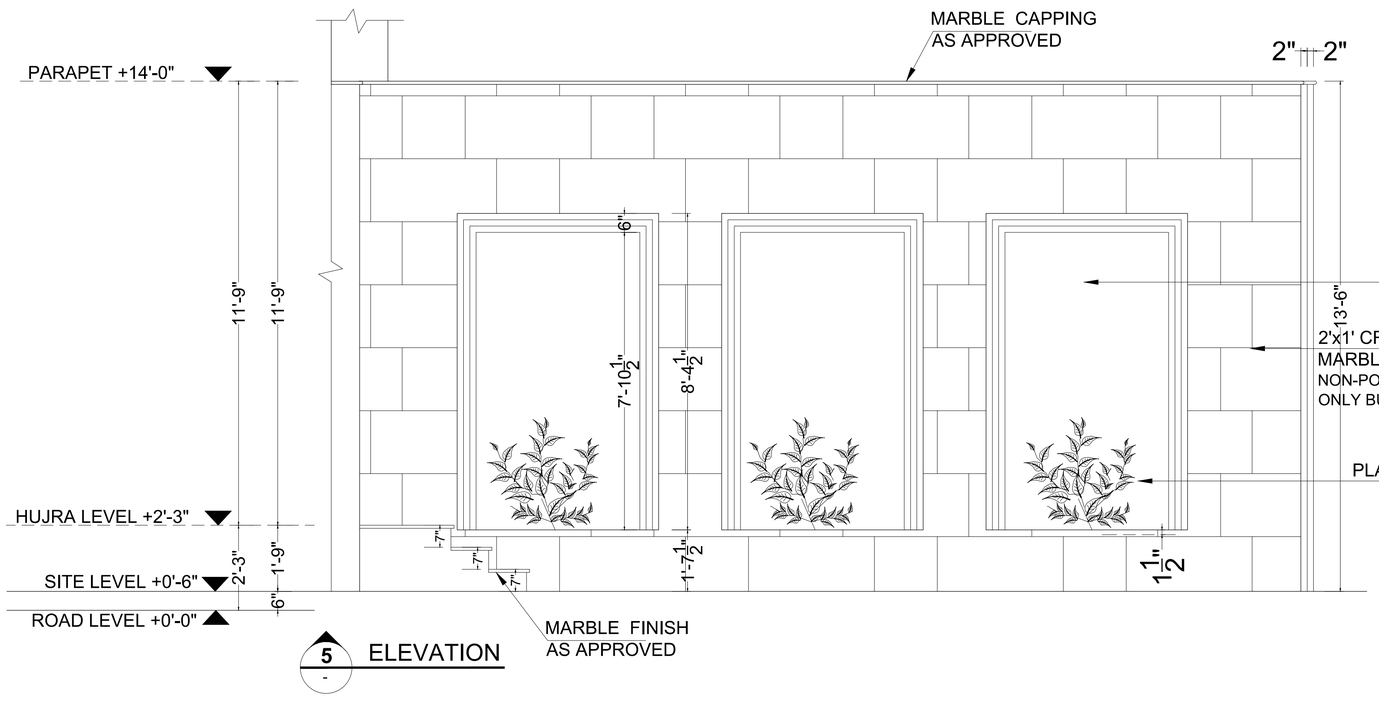

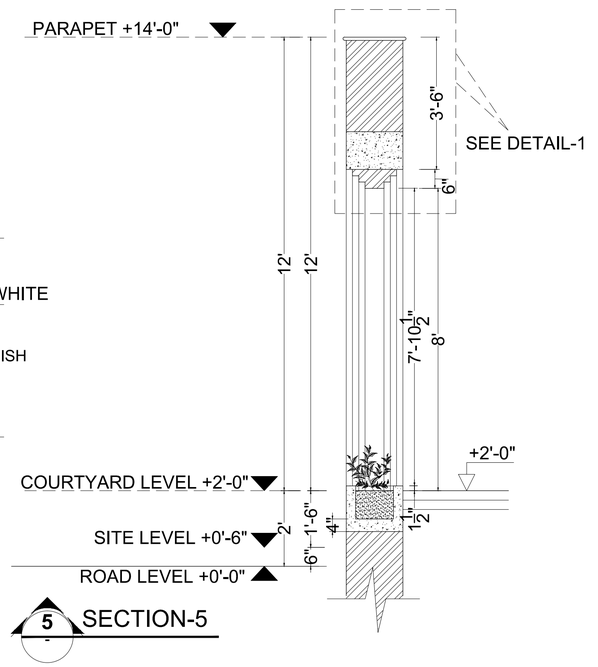

DETAIL-5

Building North:

Q
N

Project Name & Address:

TARIQ MASJID

Client Name:

EASTERN HOUSING

Project number:	Drawing Number:
2024.09.0021	AR-22

Sheet Title:

DETAIL-5

Date Created:	Scale:
24-07- 2024	N.T.S

Design by :	Drawn by :	Check by :
ALI HAMZA	MONAM ALI	A.Ibrahim

GENERAL NOTES :

RECORD DRAWING

DATE	REV#	DESCRIPTION


KEY PLAN:

This drawing is to be read in conjunction with all related dwgs. Do not scale from this drawing. All dimensions must be checked and verified on site before commencing any work or producing shop drawings. The originator should be notified immediately of any discrepancy.
This drawing is copyright and remains the property of AIA.


AHMED IBRAHIM ARCHITECTS

ARCHITECTURE | INTERIOR DESIGN | CONSTRUCTION
PLANNING | DESIGN | LANDSCAPE

288 G1 Johar town Lahore
aia.designteam@gmail.com

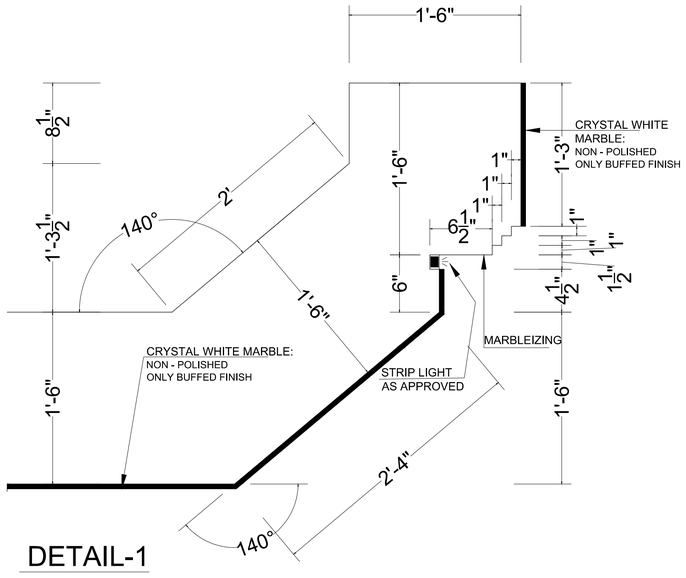



DETAIL-1

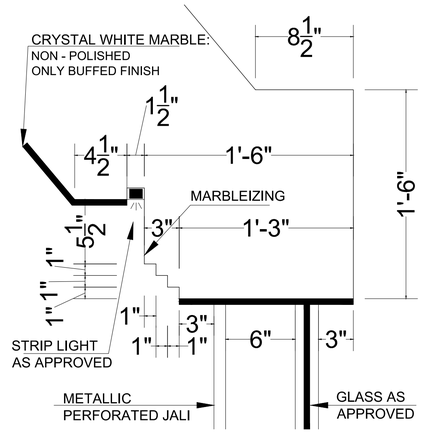


DETAIL-2

DETAIL-6

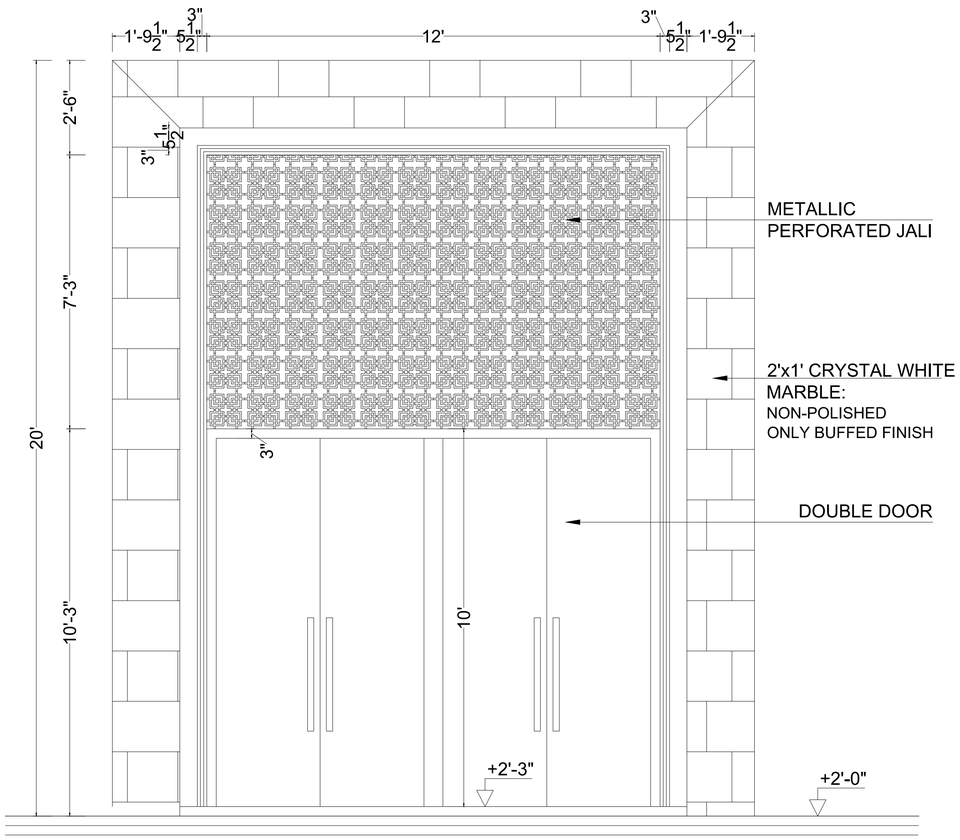

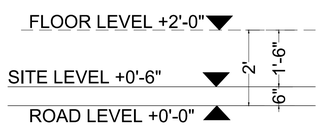

6 - ELEVATION

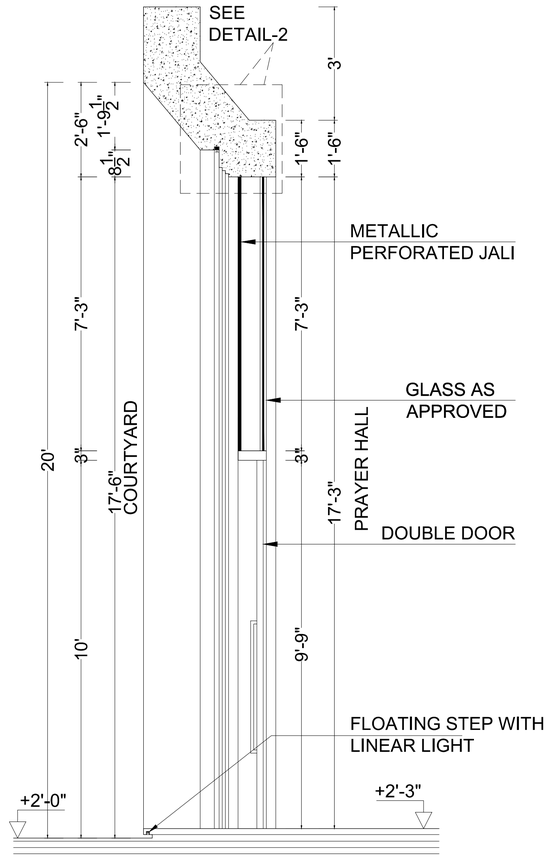

6 - SECTION-6

Building North:

Q
N

Project Name & Address:

TARIQ MASJID

Client Name:

EASTERN HOUSING

Project number:	Drawing Number:
2024.09.0021	AR-23

Sheet Title: DETAIL-6

Date Created:	Scale:
24-07- 2024	N.T.S

Design by :	Drawn by :	Check by :
ALI HAMZA	MONAM ALI	A.Ibrahim

GENERAL NOTES :

RECORD DRAWING

DATE	REV#	DESCRIPTION


KEY PLAN:

This drawing is to be read in conjunction with all related dwgs. Do not scale from this drawing. All dimensions must be checked and verified on site before commencing any work or producing shop drawings. The originator should be notified immediately of any discrepancy.
This drawing is copyright and remains the property of AIA.


AHMED IBRAHIM ARCHITECTS

ARCHITECTURE | INTERIOR DESIGN | CONSTRUCTION
PLANNING | DESIGN | LANDSCAPE


288 G1 Johar town Lahore
aia.designteam@gmail.com

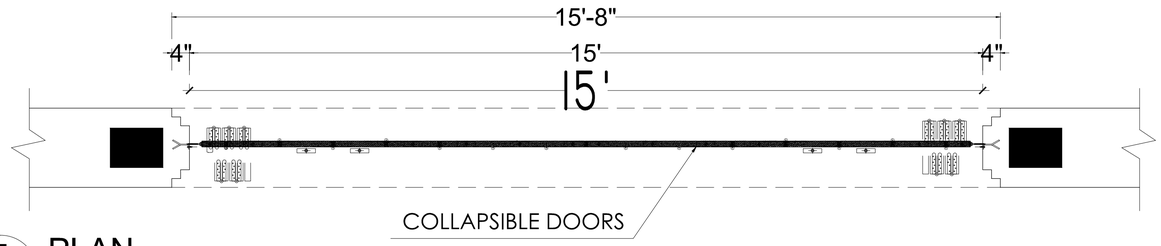


7 / - PLAN
DETAIL-7

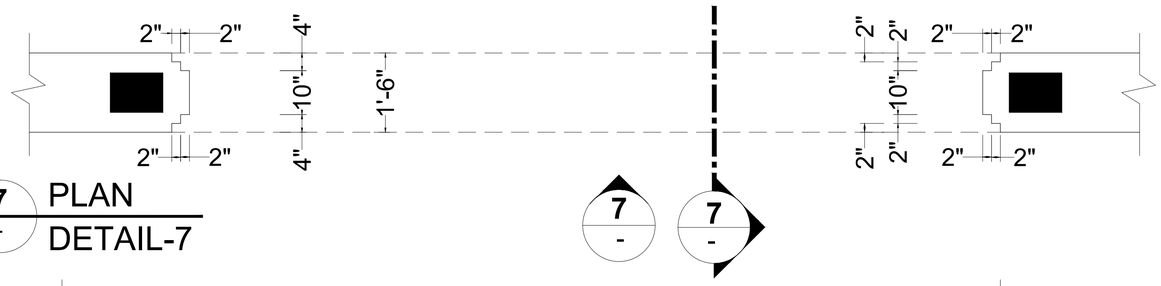


7 / - PLAN
DETAIL-7

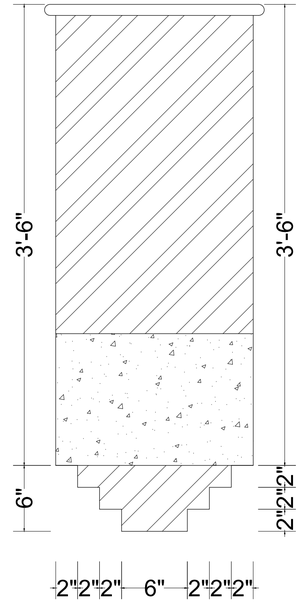

DETAIL-1

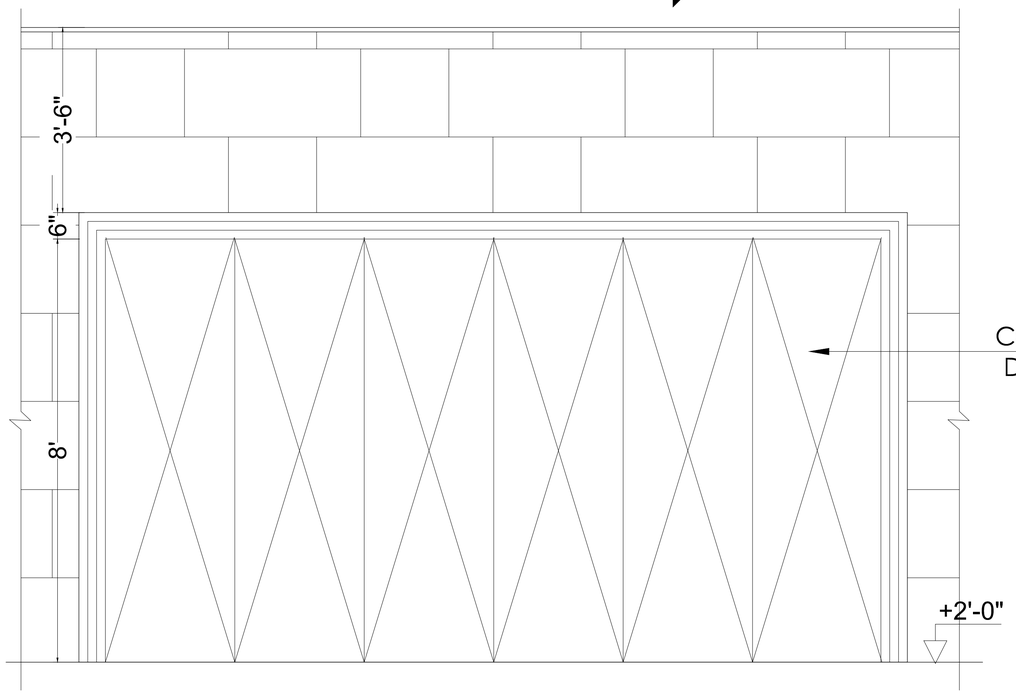

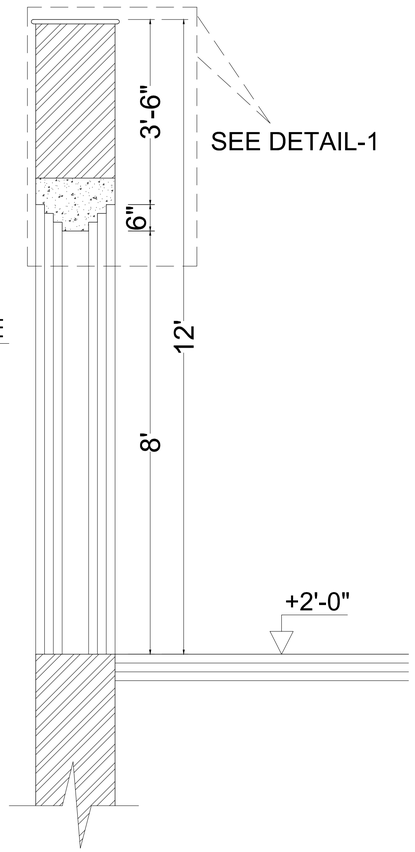

DETAIL-7

Q
N

Project Name & Address:

TARIQ MASJID

Client Name:

EASTERN HOUSING

Project number: 2024.09.0021

Drawing Number: AR-24

Sheet Title: DETAIL-7

Date Created: 24-07- 2024

Scale: N.T.S

Design by : ALI HAMZA

Drawn by : MONAM ALI

Check by : A.Ibrahim

GENERAL NOTES :

RECORD DRAWING

DATE	REV#	DESCRIPTION


KEY PLAN:

This drawing is to be read in conjunction with all related dwgs. Do not scale from this drawing. All dimensions must be checked and verified on site before commencing any work or producing shop drawings. The originator should be notified immediately of any discrepancy.
This drawing is copyright and remains the property of AIA.

AHMED IBRAHIM ARCHITECTS

ARCHITECTURE | INTERIOR DESIGN | CONSTRUCTION
PLANNING | DESIGN | LANDSCAPE

288 G1 Johar town Lahore
aia.designteam@gmail.com

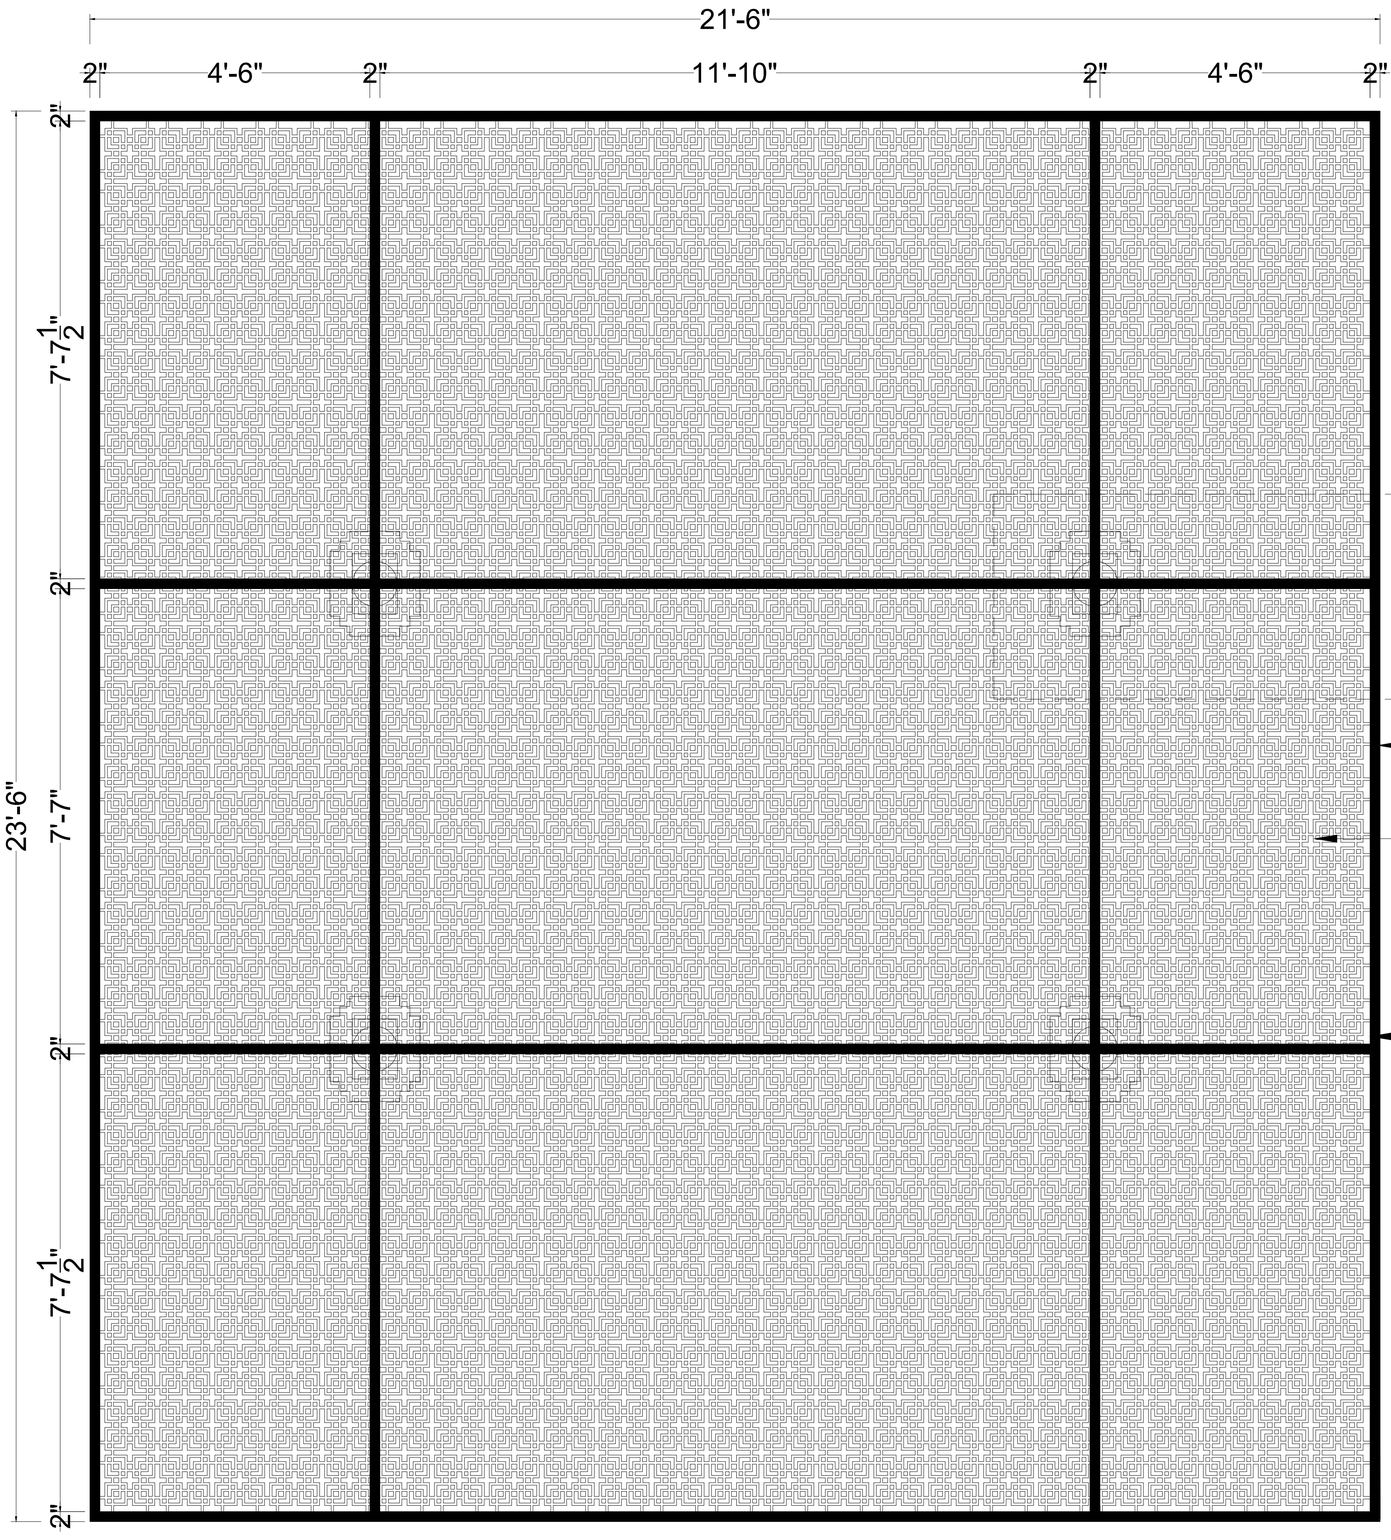

DETAIL-8

Q

N

Project Name & Address:

TARIQ MASJID

Client Name:

EASTERN HOUSING

Project number:	Drawing Number:
2024.09.0021	AR-25

Sheet Title:

DETAIL-8

Date Created:	Scale:
24-07- 2024	N.T.S

Design by :	Drawn by :	Check by :
ALI HAMZA	MONAM ALI	A.Ibrahim

GENERAL NOTES :

RECORD DRAWING

DATE	REV#	DESCRIPTION


KEY PLAN:

This drawing is to be read in conjunction with all related dwgs. Do not scale from this drawing. All dimensions must be checked and verified on site before commencing any work or producing shop drawings. The originator should be notified immediately of any discrepancy.
This drawing is copyright and remains the property of AIA.


AHMED IBRAHIM ARCHITECTS

ARCHITECTURE | INTERIOR DESIGN | CONSTRUCTION
PLANNING | DESIGN | LANDSCAPE

288 G1 Johar town Lahore
aia.designteam@gmail.com

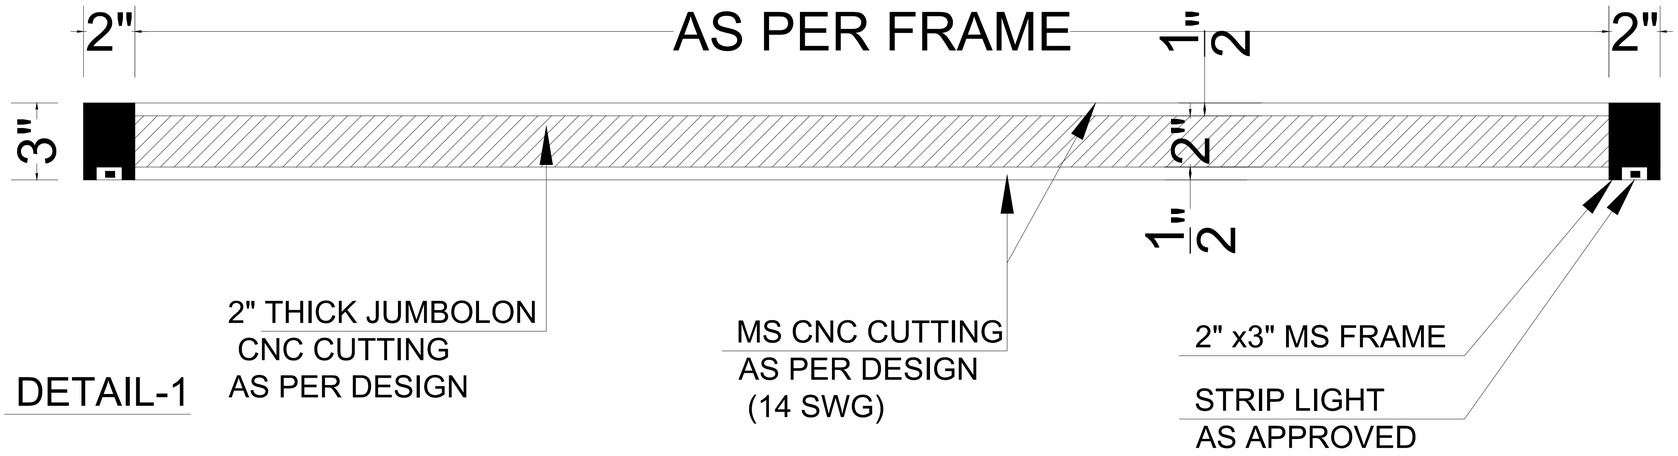

DETAIL-1

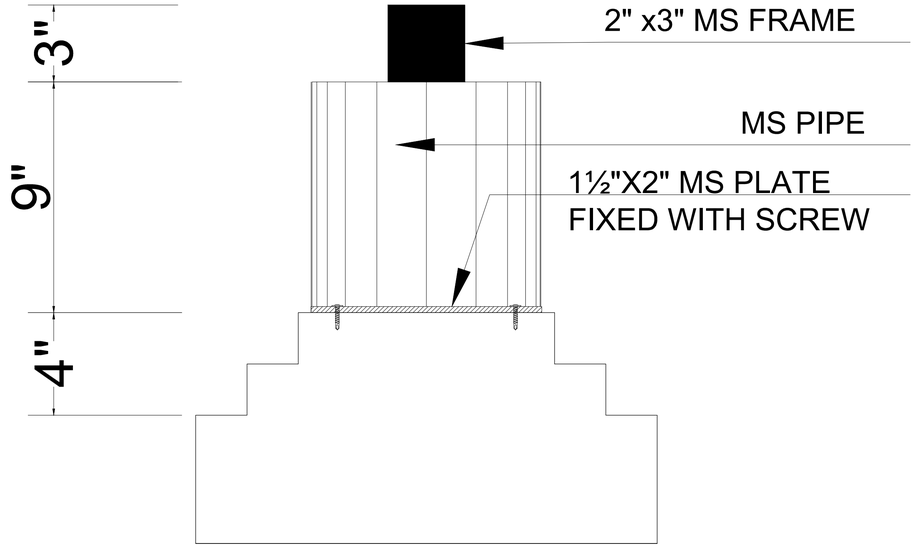

DETAIL-1

DETAIL-8

Q
N

Project Name & Address:

TARIQ MASJID

Client Name:

EASTERN HOUSING

Project number:	Drawing Number:
2024.09.0021	AR-26

Sheet Title:

DETAIL-8

Date Created:	Scale:
24-07- 2024	N.T.S

Design by :	Drawn by :	Check by :
ALI HAMZA	MONAM ALI	A.Ibrahim

GENERAL NOTES :

RECORD DRAWING

DATE	REVI	DESCRIPTION


KEY PLAN:

This drawing is to be read in conjunction with all related dwgs.
Do not scale from this drawing. All dimensions must be checked and verified on site before commencing any work or producing shop drawings. The originator should be notified immediately of any discrepancy.
This drawing is copyright and remains the property of AIA.


AHMED IBRAHIM ARCHITECTS

ARCHITECTURE | INTERIOR DESIGN | CONSTRUCTION
PLANNING | DESIGN | LANDSCAPE


288 G1 Johar town Lahore
aia.designteam@gmail.com

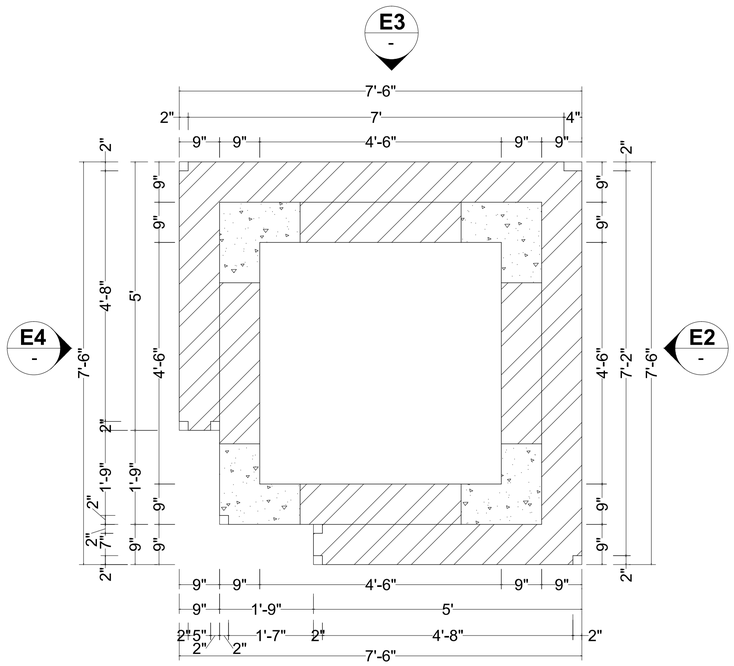


PLAN AT 2'-0"

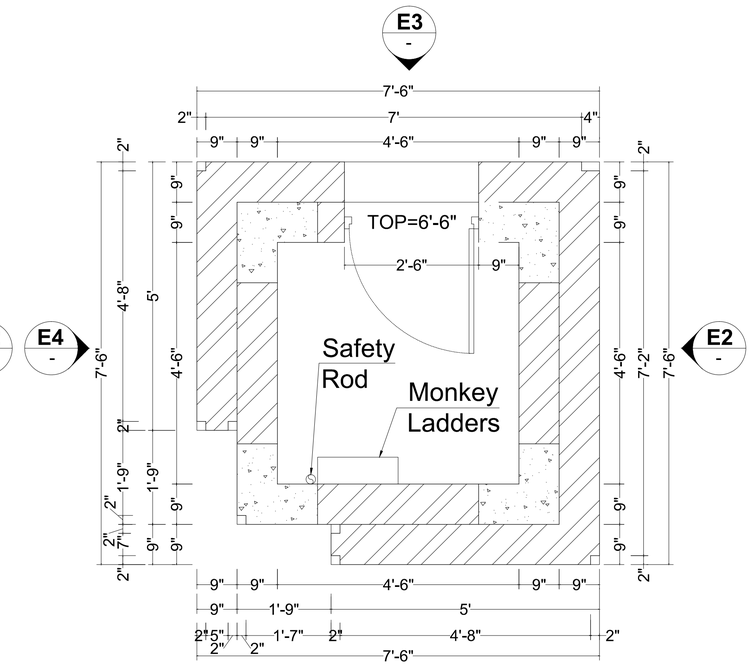

PLAN AT 4'-0"

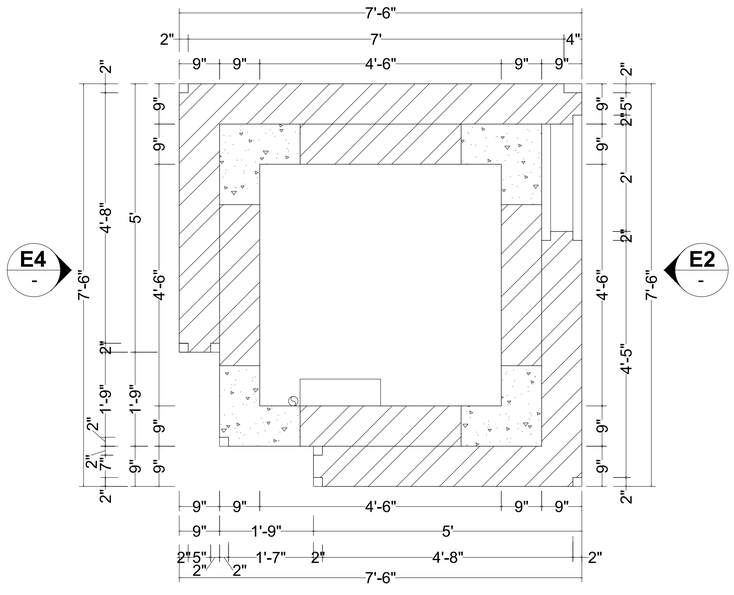

PLAN AT 19'-0"

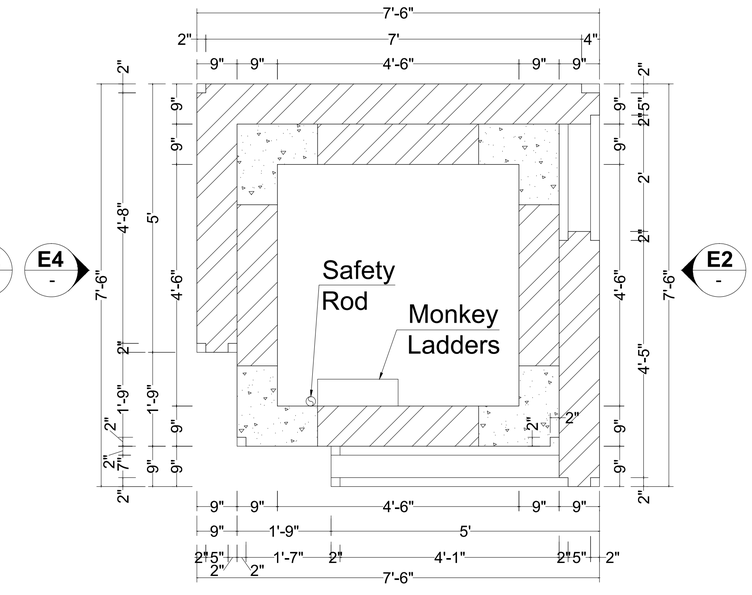

PLAN AT 26'-0"

DETAIL-9

Q
N

Project Name & Address:

TARIQ MASJID

Client Name:

EASTERN HOUSING

Project number:	Drawing Number:
2024.09.0021	AR-27

Sheet Title:

DETAIL-9

Date Created:	Scale:
24-07- 2024	N.T.S

Design by :	Drawn by :	Check by :
ALI HAMZA	MONAM ALI	A.Ibrahim

GENERAL NOTES :

RECORD DRAWING

DATE	REV	DESCRIPTION


KEY PLAN:

This drawing is to be read in conjunction with all related dwgs. Do not scale from this drawing. All dimensions must be checked and verified on site before commencing any work or producing shop drawings. The originator should be notified immediately of any discrepancy.
This drawing is copyright and remains the property of AIA.


AHMED IBRAHIM ARCHITECTS

ARCHITECTURE | INTERIOR DESIGN | CONSTRUCTION
PLANNING | DESIGN | LANDSCAPE


288 G1 Johar town Lahore
aia.designteam@gmail.com

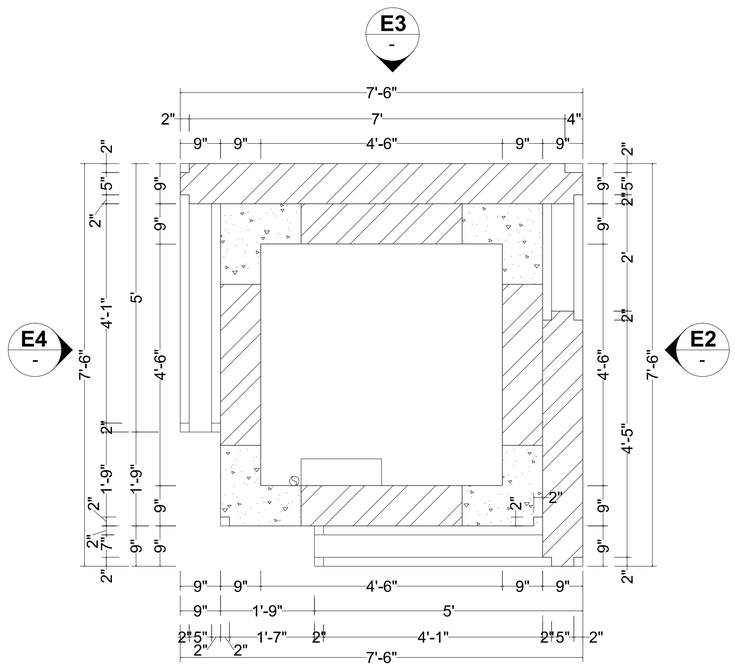


PLAN AT 35'-0"

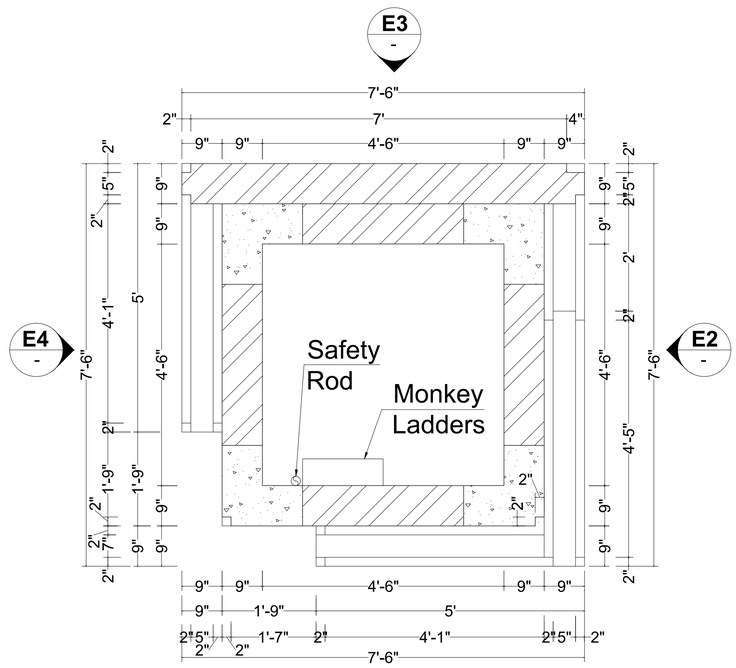


PLAN AT 41'-0"

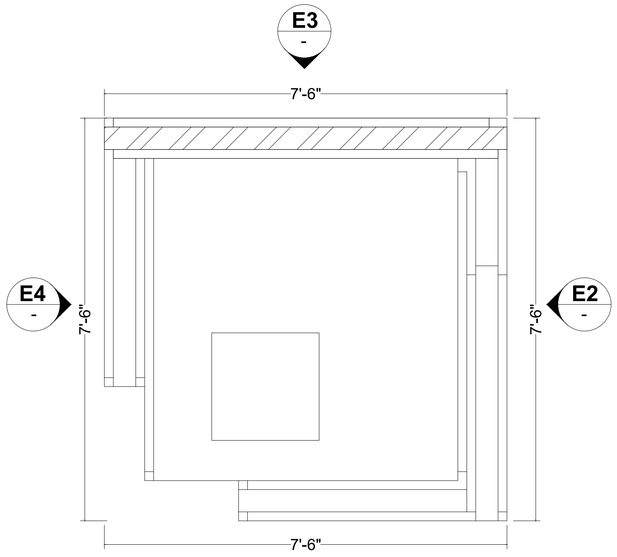


PLAN AT TOP

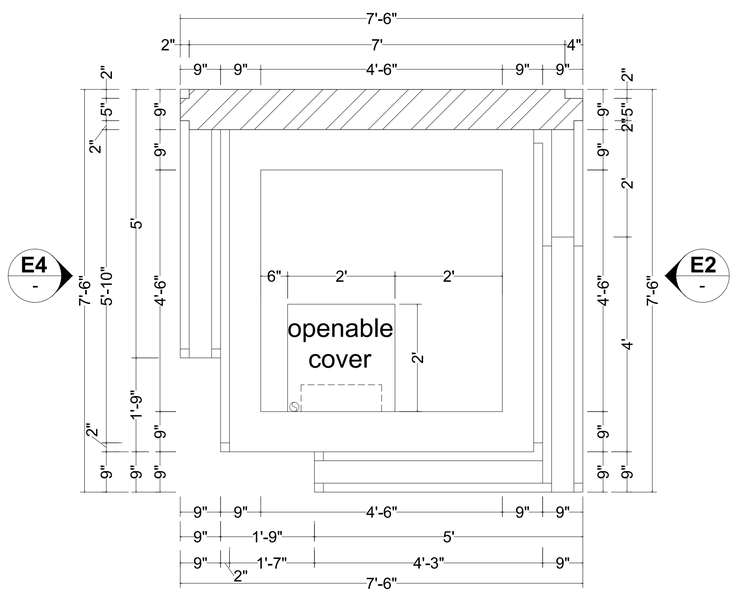


PLAN AT 51'-0"

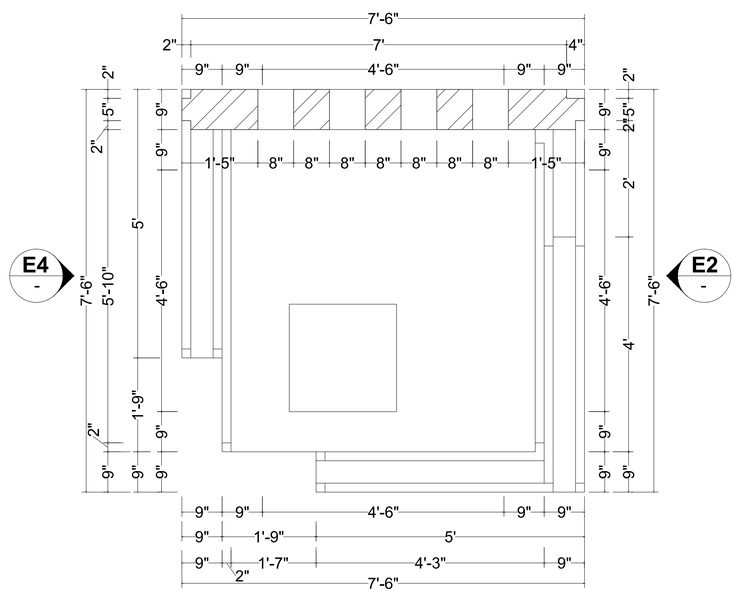

PLAN AT 54'-6"

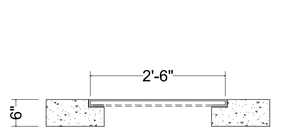

DETAIL-1

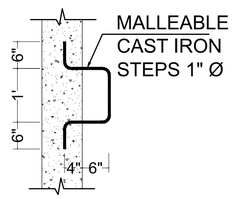

DETAIL-2

DETAIL-9

Q

N

Project Name & Address:

TARIQ MASJID

Client Name:

EASTERN HOUSING

Project number:	Drawing Number:
2024.09.0021	AR-28

Sheet Title:

DETAIL-9

Date Created:	Scale:
24-07- 2024	N.T.S

Design by :	Drawn by :	Check by :
ALI HAMZA	MONAM ALI	A.Ibrahim

GENERAL NOTES :

RECORD DRAWING

DATE	REV#	DESCRIPTION


KEY PLAN:

This drawing is to be read in conjunction with all related dwgs. Do not scale from this drawing. All dimensions must be checked and verified on site before commencing any work or producing shop drawings. The originator should be notified immediately of any discrepancy.
This drawing is copyright and remains the property of AIA.


AHMED IBRAHIM ARCHITECTS

ARCHITECTURE | INTERIOR DESIGN | CONSTRUCTION
PLANNING | DESIGN | LANDSCAPE


288 G1 Johar town Lahore
aia.designteam@gmail.com

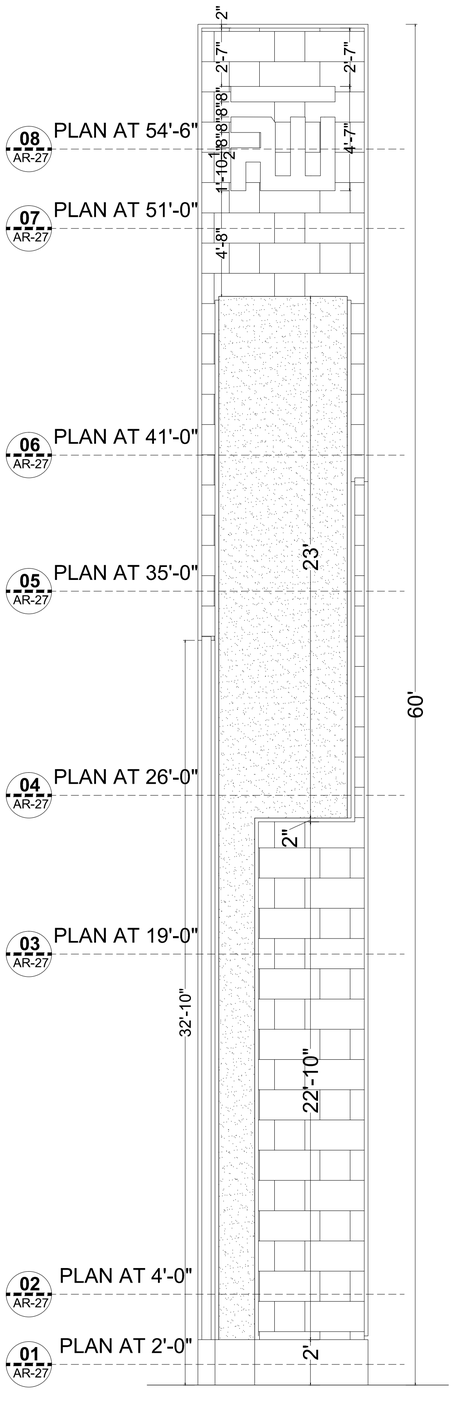


E1 AR-27 ELEVATION-1

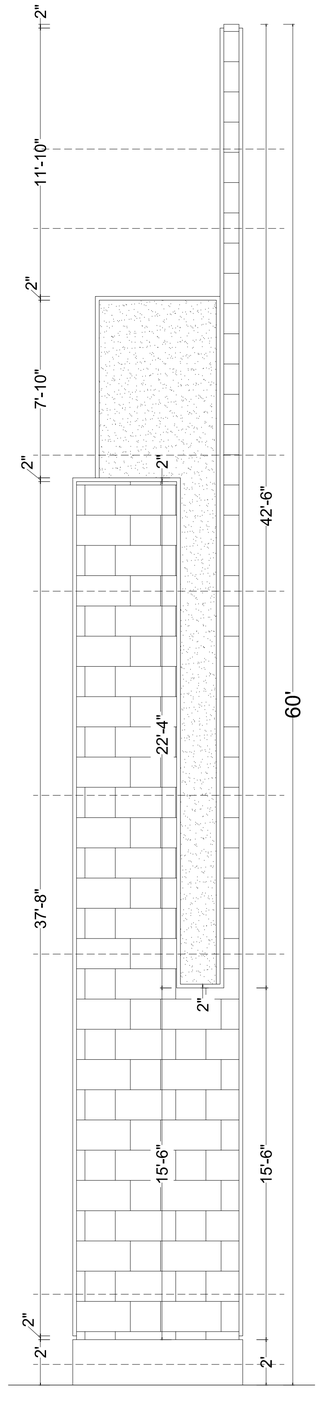


E2 AR-27 ELEVATION-2

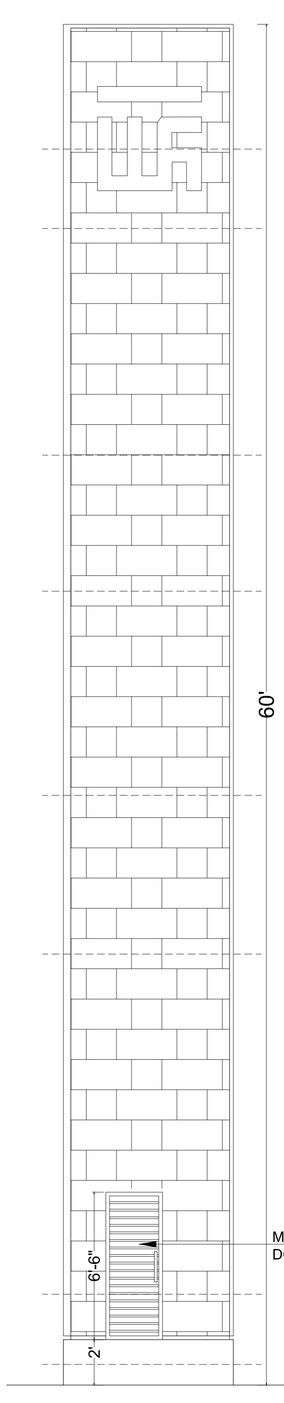

E3 AR-27 ELEVATION-3

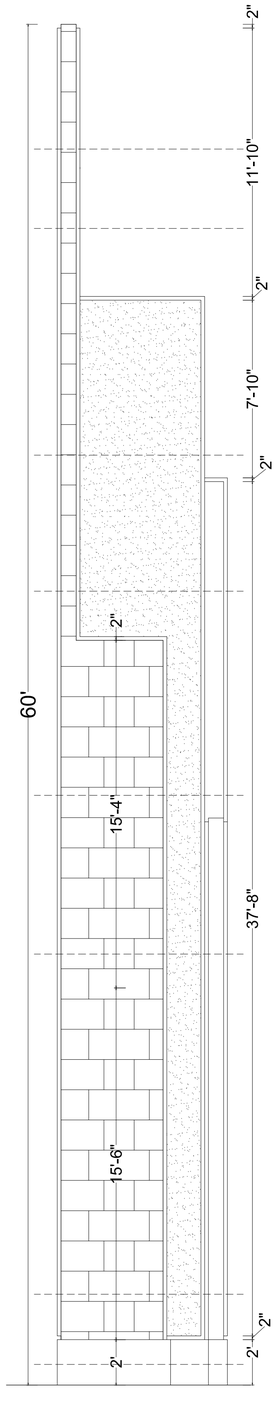

E4 AR-27 ELEVATION-4

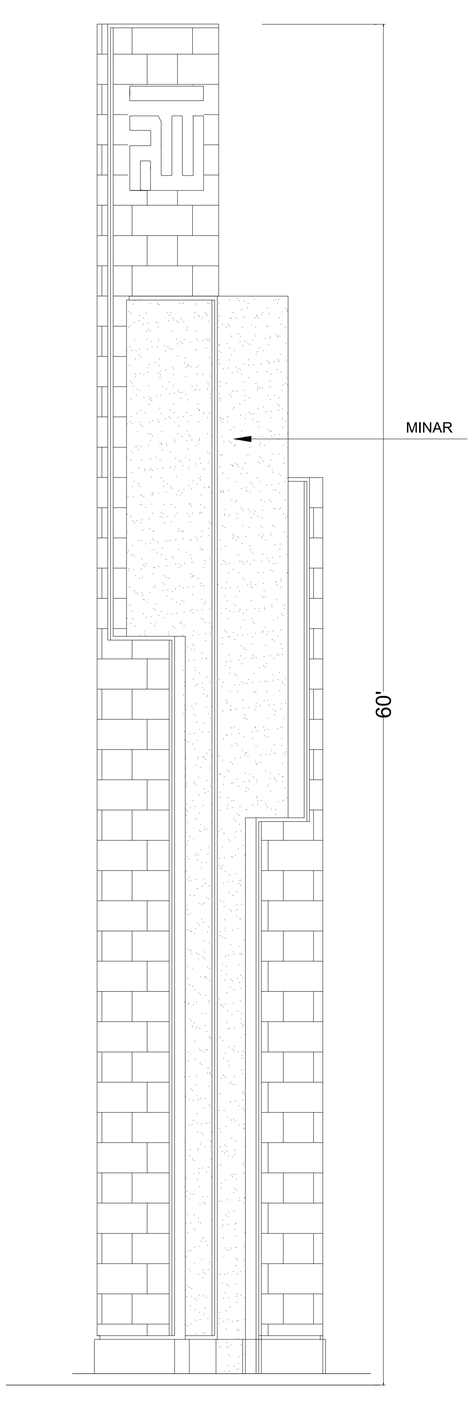

E AR-27 WEST SIDE ELEVATION

DETAIL-9

Q
N

Project Name & Address:

TARIQ MASJID

Client Name:

EASTERN HOUSING

Project number:	Drawing Number:
2024.09.0021	AR-29

Sheet Title:

DETAIL-9

Date Created:	Scale:
24-07- 2024	N.T.S

Design by :	Drawn by :	Check by :
ALI HAMZA	MONAM ALI	A.Ibrahim

GENERAL NOTES :

RECORD DRAWING

DATE	REV#	DESCRIPTION


KEY PLAN:

This drawing is to be read in conjunction with all related dwgs. Do not scale from this drawing. All dimensions must be checked and verified on site before commencing any work or producing shop drawings. The originator should be notified immediately of any discrepancy.
This drawing is copyright and remains the property of AIA.


AHMED IBRAHIM ARCHITECTS


ARCHITECTURE | INTERIOR DESIGN | CONSTRUCTION
PLANNING | DESIGN | LANDSCAPE

288 G1 Johar town Lahore
aia.designteam@gmail.com

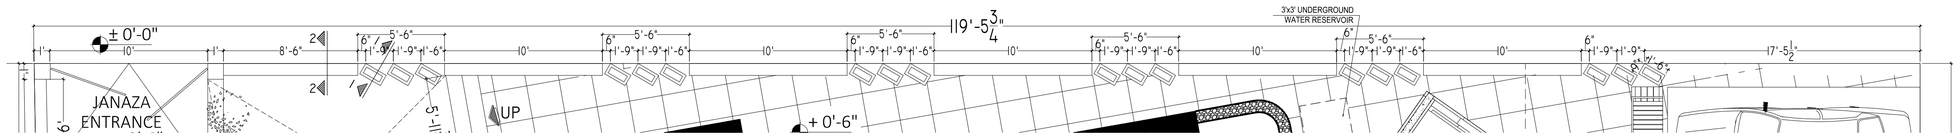

BOUNDARY WALL PLAN

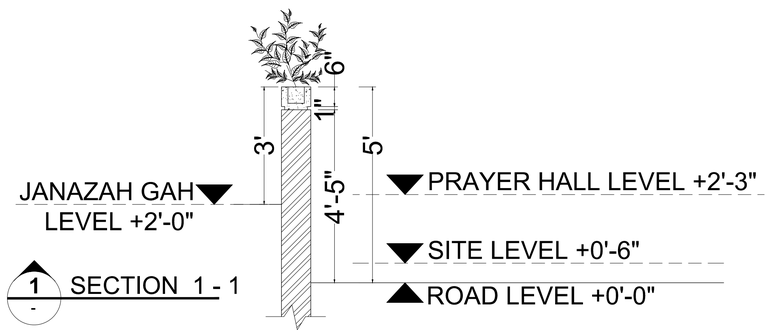

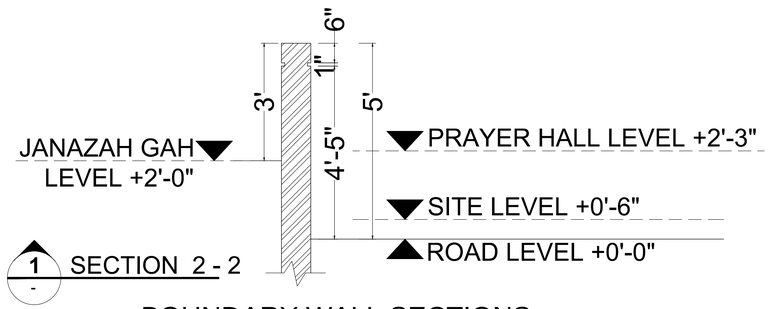

BOUNDARY WALL SECTIONS

DOORS SCHEDULE			
SR	DOORS	DIMESION	SILL
1	D1	15'-0" x 8'-0"	0'-0"
2	D2	12'-0"X10'-0"	0'-0"
3	D3	6'-0" x 8'-0"	0'-0"
4	D4	4'-0" x 8'-0"	0'-0"
5	D5	3'-0" x 8'-0"	0'-0"
6	D6	3'-0" x 7'-0"	0'-0"
7	D7	2'-6" x 7'-0"	0'-0"

WINDOWS SCHEDULE			
SR	WINDOWS	DIMENSION	SILL
1	W1	33'-9" x 7'-9"	0'-3"
2	W2	17'-0" x 7'-9"	0'-3"
3	W3	6'-0" x 7'-9"	0'-3"
4	W4	4'-0" x 7'-9"	0'-3"

1 DETAIL-10

Building North:

Q N

Project Name & Address:

TARIQ MASJID

Client Name:

EASTERN HOUSING

Project number: 2024.09.0021

Drawing Number: AR-30

Sheet Title: DETAIL-10

Date Created: 24-07- 2024

Scale: N.T.S

Design by : ALI HAMZA | Drawn by : MONAM ALI | Check by : A.Ibrahim

GENERAL NOTES :

RECORD DRAWING

DATE	REVI	DESCRIPTION

KEY PLAN:


This drawing is to be read in conjunction with all related dwgs. Do not scale from this drawing. All dimensions must be checked and verified on site before commencing any work or producing shop drawings. The originator should be notified immediately of any discrepancy.
This drawing is copyright and remains the property of AIA.

AHMED IBRAHIM ARCHITECTS

ARCHITECTURE | INTERIOR DESIGN | CONSTRUCTION
PLANNING | DESIGN | LANDSCAPE

288 G1 Johar town Lahore
aia.designteam@gmail.com

STRUCTURAL DRAWING

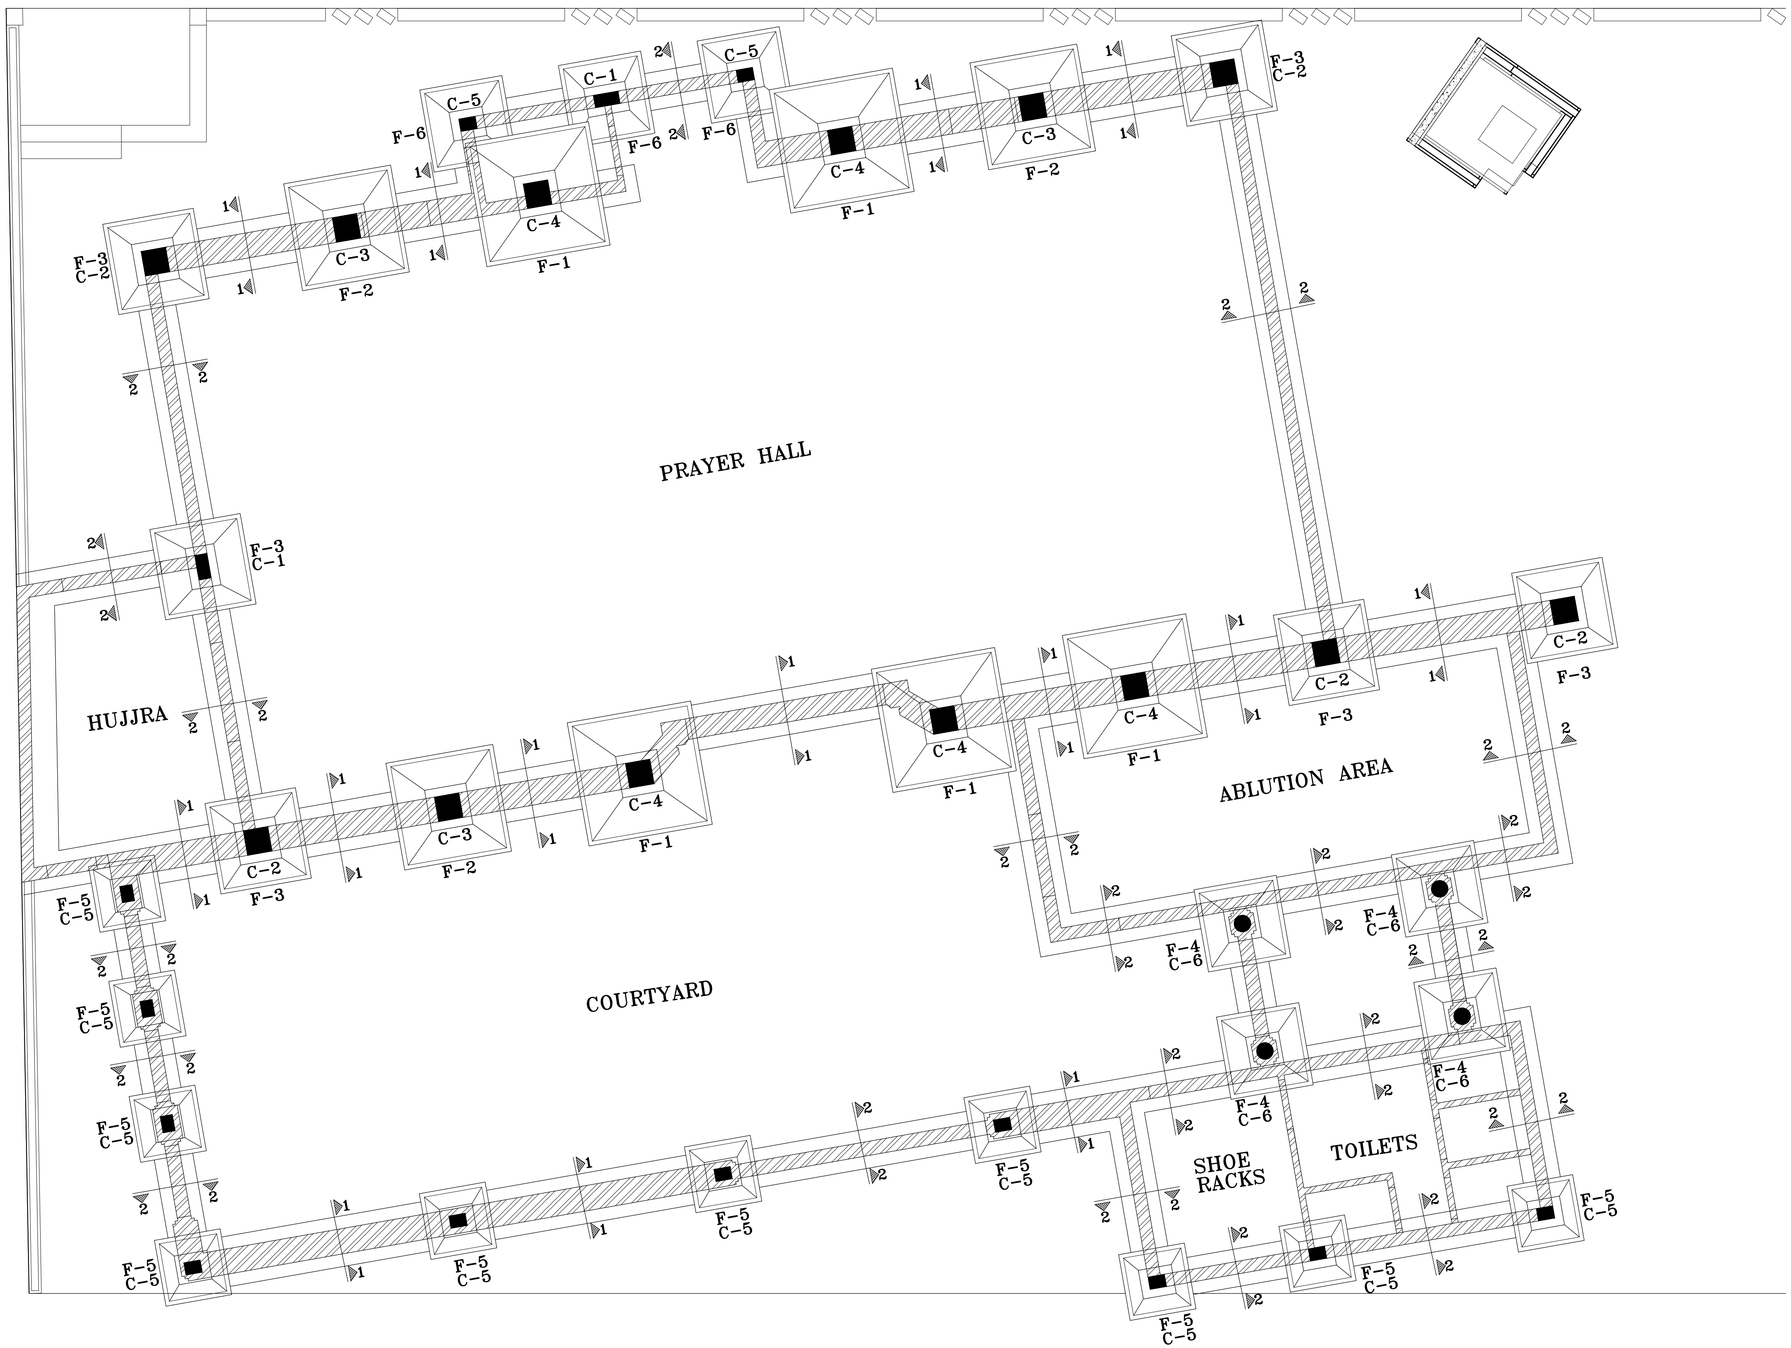

NOTE:-

1—FOR GENERAL NOTES SEE DRAWING # S—01 # S—02


2—FOR FOOTING DETAILS SEE DRAWING # S—04

PROJECT:
MASJID AT EASTERN HOUSING SCHEME,
NEAR QUAID—E—AZAM INTERCHANGE,
RING ROAD LAHORE.


DRAWING TITLE:
FOUNDATION EXCAVATION PLAN

DESIGNED BY: ENGR. ATIQ	DATE: 23—07—2024
CHECKED BY: ENGR. ATIQ	REVISE DATE: 00—00—0000
DRAWN BY: IRFAN	DRAWING. NO. S—03


CONSULTING ENGINEERS:
ATIQ ASSOCIATES
Office # 612, 6th Floor, Al-Qadir Heights,
1-Babar Block, New Garden Town, Lahore.
Tel: 042-35847804, Cell: 0321-8491407
E-Mail: engratiq2000@gmail.com
Web: www.atiqassociates.com

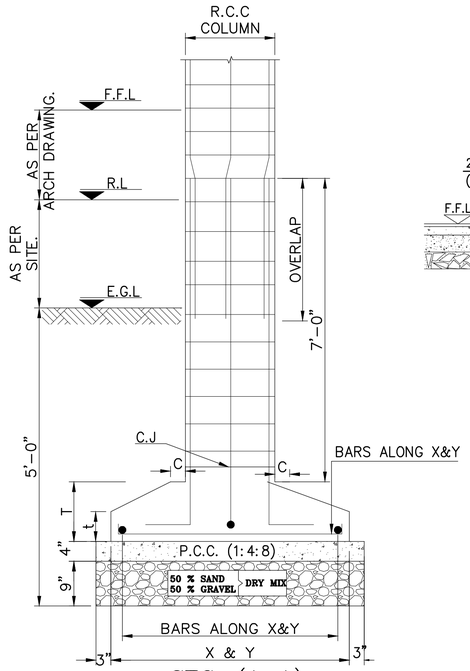


SEC. (A-A)

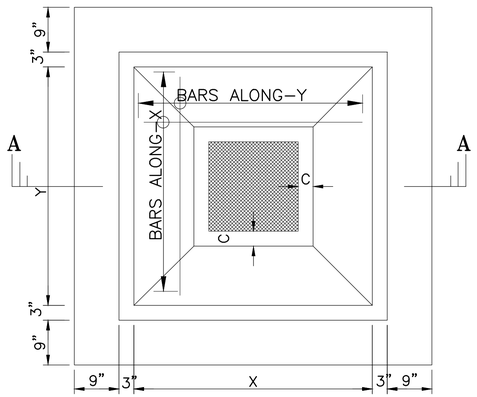


TYPICAL COLUMN FOOTING PLAN

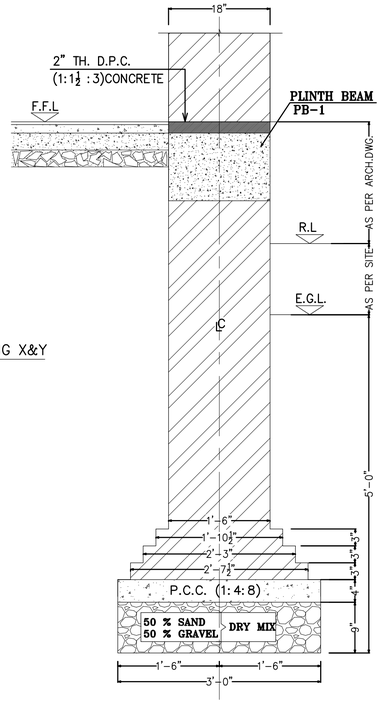


SECTION: 1-1
18" THICK BRICK
WALL DETAIL

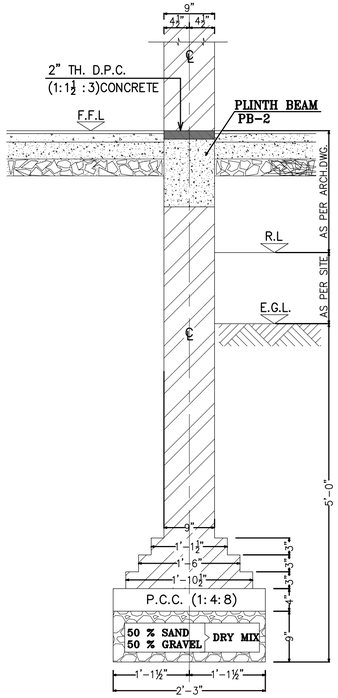


SECTION: 2-2
9" THICK
BRICK WALL DETAIL

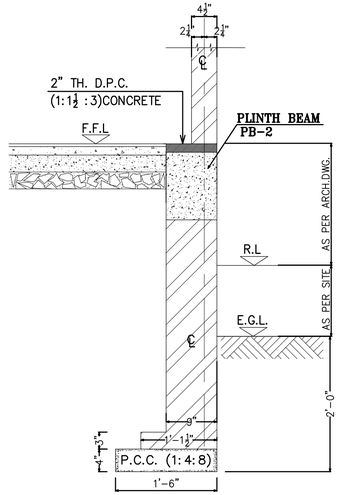


BOUNDRY WALL DETAIL

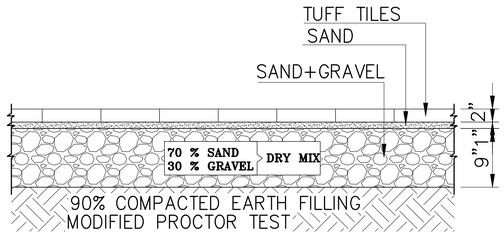


PARKING PAVEMENT DETAIL

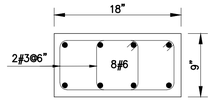


COLUMN C-1
(F'c= 4500 PSI)

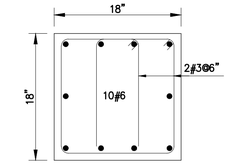


COLUMN C-2
(F'c= 4500 PSI)

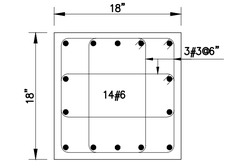


COLUMN C-3
(F'c= 4500 PSI)

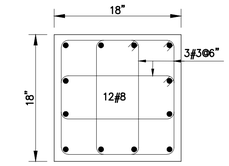


COLUMN C-4
(F'c= 4500 PSI)

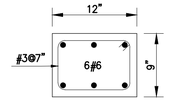


COLUMN C-5
(F'c= 4500 PSI)

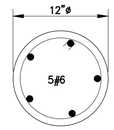

COLUMN C-6
(F'c= 4500 PSI)

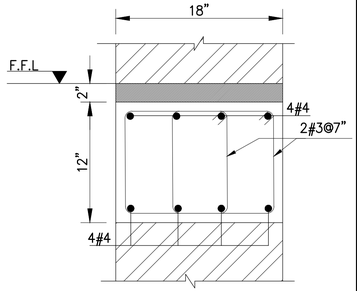

PLINTH BEAM
PB-1

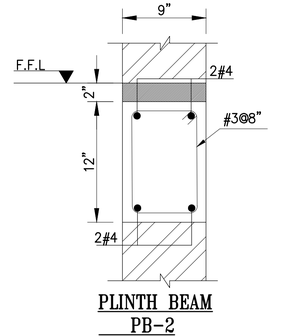

PLINTH BEAM
PB-2

SCHEDULE OF FOOTING

	SIZE		THICKNESS			REINFORCEMENT	
MARK	X	Y	T	t	C	ALONG-X	ALONG-Y
F-1	7'-0"	7'-0"	18"	9"	7½"	#4@7"	#4@7"
F-2	6'-0"	6'-0"	15"	8"	6"	#4@7"	#4@7"
F-3	5'-0"	5'-0"	15"	7"	6"	#4@8"	#4@8"
F-4	4'-6"	4'-6"	12"	6"	4½"	#3@7"	#3@7"
F-5	3'-6"	3'-6"	12"	6"	4½"	#3@8"	#3@8"
F-5	4'-6"	4'-6"	15"	7"	6"	#4@8"	#4@8"

LEGEND:

1- DAMP PROOF COURSE (D.P.C)
2- EXISTING GROUND LEVEL (E.G.L)
3- ROAD LEVEL (R.L)
4- FINISH FLOOR LEVEL (F.F.L)
5- SIDE PASSAGE LEVEL (S.P.L)


NOTE:-
1-FOR GENERAL NOTES SEE DRAWING # S-01 # S-02

PROJECT:
MASJID AT EASTERN HOUSING SCHEME,
NEAR QUAID-E-AZAM INTERCHANGE,
RING ROAD LAHORE.


DRAWING TITLE:
FOUNDATION SECTION DETAIL

DESIGNED BY	ENGR. ATIQ	DATE:	24-07-2024
CHECKED BY	ENGR. ATIQ	REVISE DATE:	00-00-0000
DRAWN BY:	IRFAN	DRAWING. NO.	S-04


CONSULTING ENGINEERS:
ATIQ ASSOCIATES
Office # 612, 6th Floor, Al-Qadir Heights,
1-Babar Block, New Garden Town, Lahore.
Tel: 042-35847804, Cell: 0321-8491407
E-Mail: engratiq20000@gmail.com
Web: www.atiqassociates.com

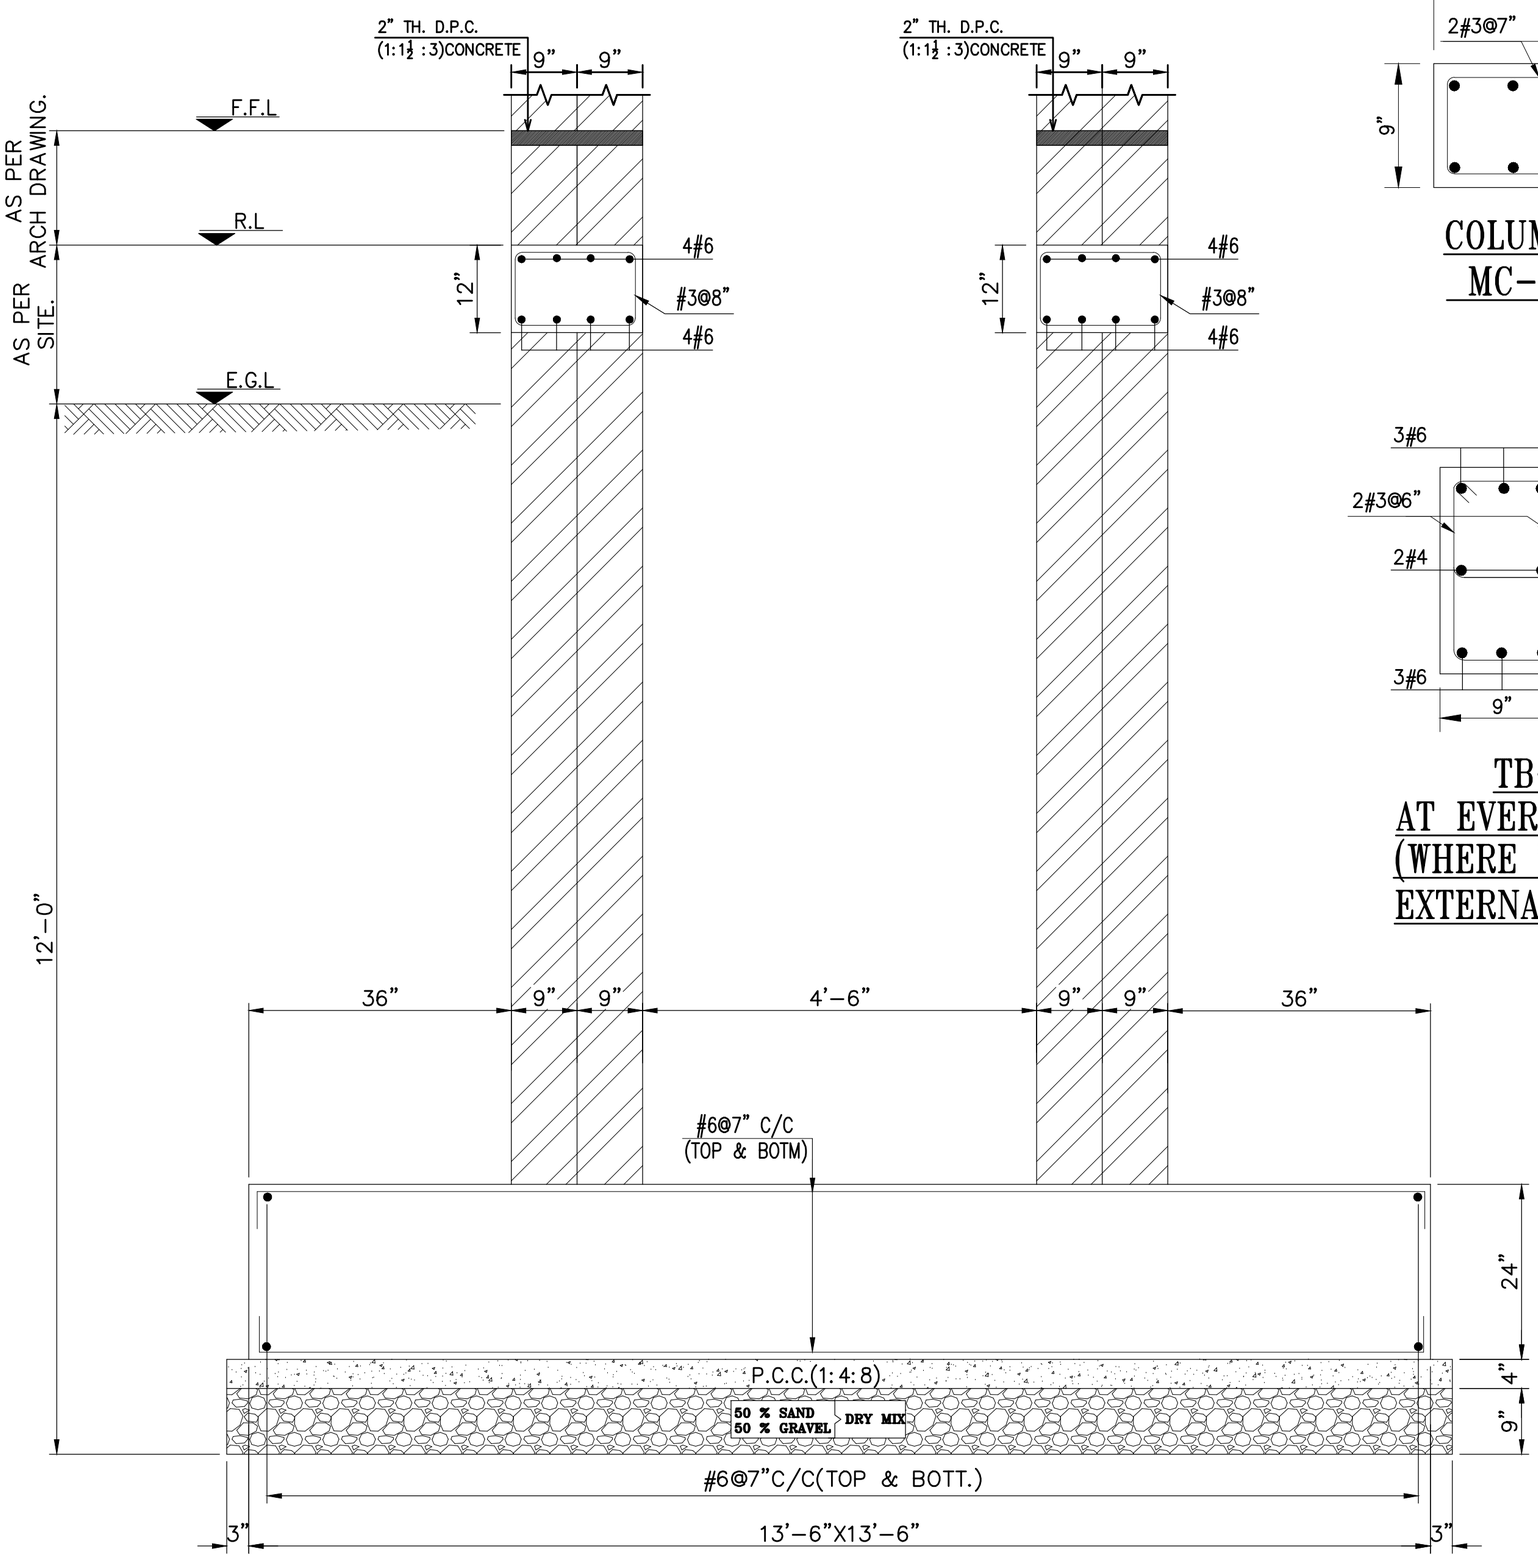


MINARET FOOTING DETAIL
SECTION A-A

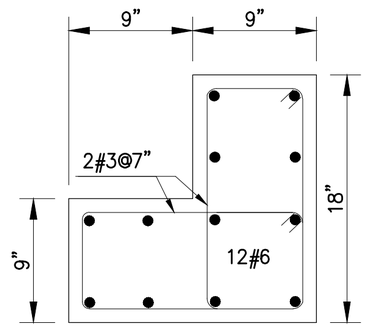


COLUMN
MC-1

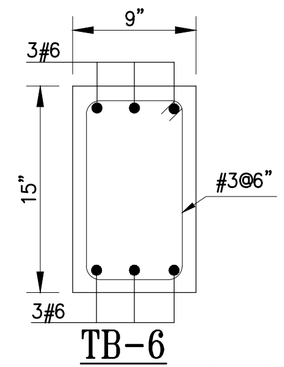


TB-6
AT EVERY 10'-0"
(WHERE THERE IS
NO EXTERNAL WALL)

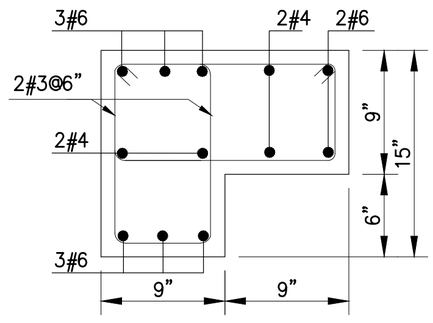


TB-6A
AT EVERY 10'-0"
(WHERE THERE IS
EXTERNAL WALL)

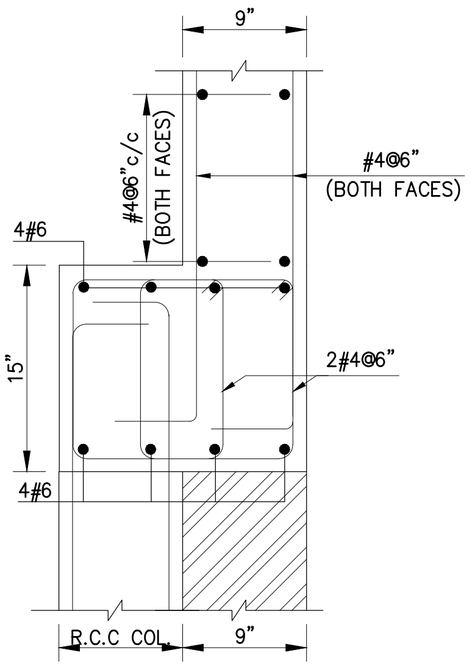

AT TOP LEVEL
OF CORE

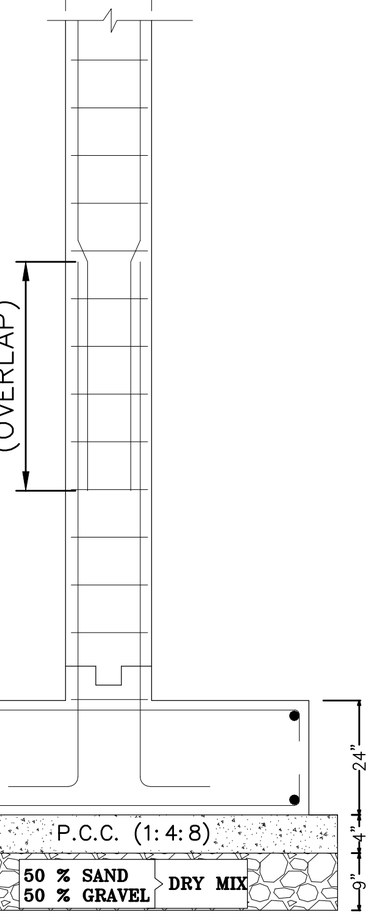

TYP. COLUMN DOWEL DETAIL

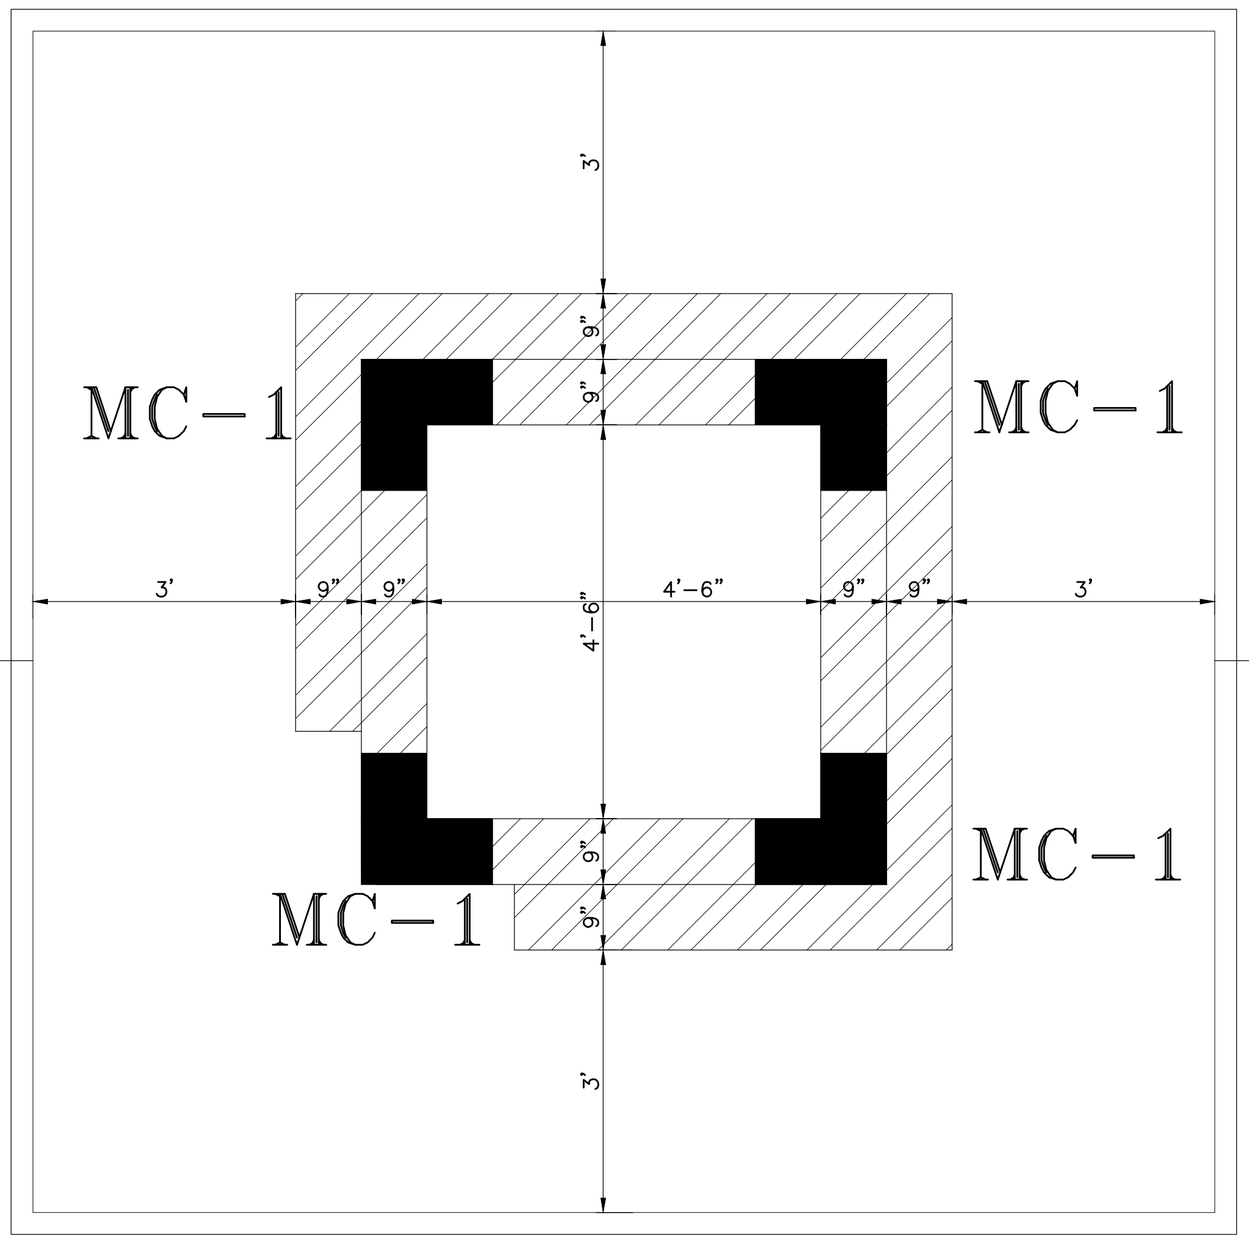

MINARET FOOTING PLAN

NOTE:-

1-FOR GENERAL NOTES SEE DRAWING # S-01 # S-02
















PROJECT:
MASJID AT EASTERN HOUSING SCHEME,
NEAR QUAID-E-AZAM INTERCHANGE,
RING ROAD LAHORE.


DRAWING TITLE:
MINARET DETAIL

DESIGNED BY: ENGR. ATIQ	DATE: 23-07-2024
CHECKED BY: ENGR. ATIQ	REVISE DATE: 00-00-0000
DRAWN BY: IRFAN	DRAWING. NO. S-4A

CONSULTING ENGINEERS:
ATIQ ASSOCIATES
Office # 612, 6th Floor, Al-Qadir Heights,
1-Babar Block, New Garden Town, Lahore.
Tel: 042-35847804, Cell: 0321-8491407
E-Mail: engratiq2000@gmail.com
Web: www.atiqassociates.com

STANDARD DOOR/WINDOW LINTEL BEAMS DETAIL

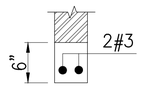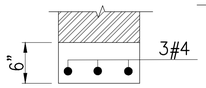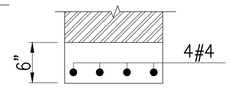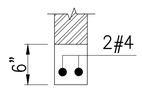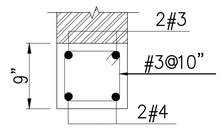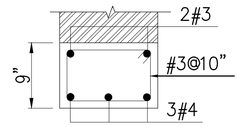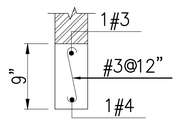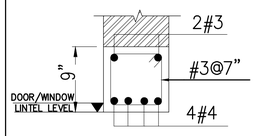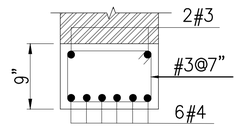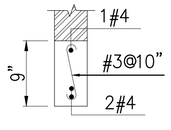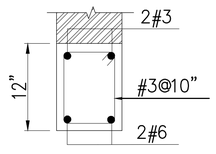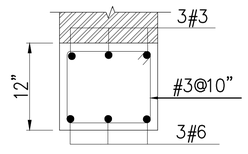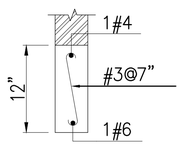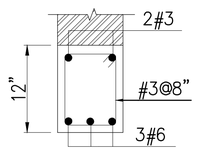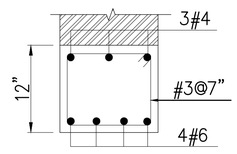SPAN RANGE	WALL THICKNESS		
	$4\frac{1}{2}$"	9"&11" CAVITY	13.5"&15.5" CAVITY
UP to 4'-0"			
4'-3" to 6'-0"			
6'-3" to 7'-6"			
7'-9" to 8'-9"			
9'-0" to 10'-0"			

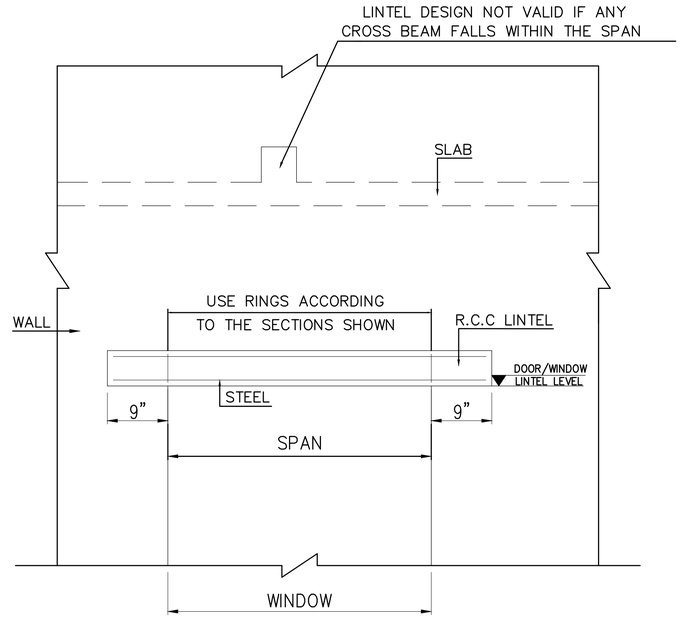

BAR CONVERSION (EQUIVALANT BARS)

#3	#4	#6
4#3	2#4	1#6
6#3	3#4	–
8#3	4#4	2#6
–	5#4	–
–	6#4	3#6
–	9#4	4#6

NOTE:-


1-FOR GENERAL NOTES SEE DRAWING # S-01 # S-02

PROJECT:
MASJID AT EASTERN HOUSING SCHEME, NEAR QUAID-E-AZAM INTERCHANGE, RING ROAD LAHORE.

DRAWING TITLE:
TYPICAL DOOR/WINDOW LINTEL BEAM DETAIL

DESIGNED BY	ENGR. ATIQ	DATE:	23-07-2024
CHECKED BY	ENGR. ATIQ	REVISE DATE:	00-00-0000
DRAWN BY:	IRFAN	DRAWING. NO.	S-05

CONSULTING ENGINEERS:
ATIQ ASSOCIATES
Office # 612, 6th Floor, Al-Qadir Heights,
1-Babar Block, New Garden Town, Lahore.
Tel: 042-35847804, Cell: 0321-8491407
E-Mail: engratiq2000@gmail.com
Web: www.atiqassociates.com

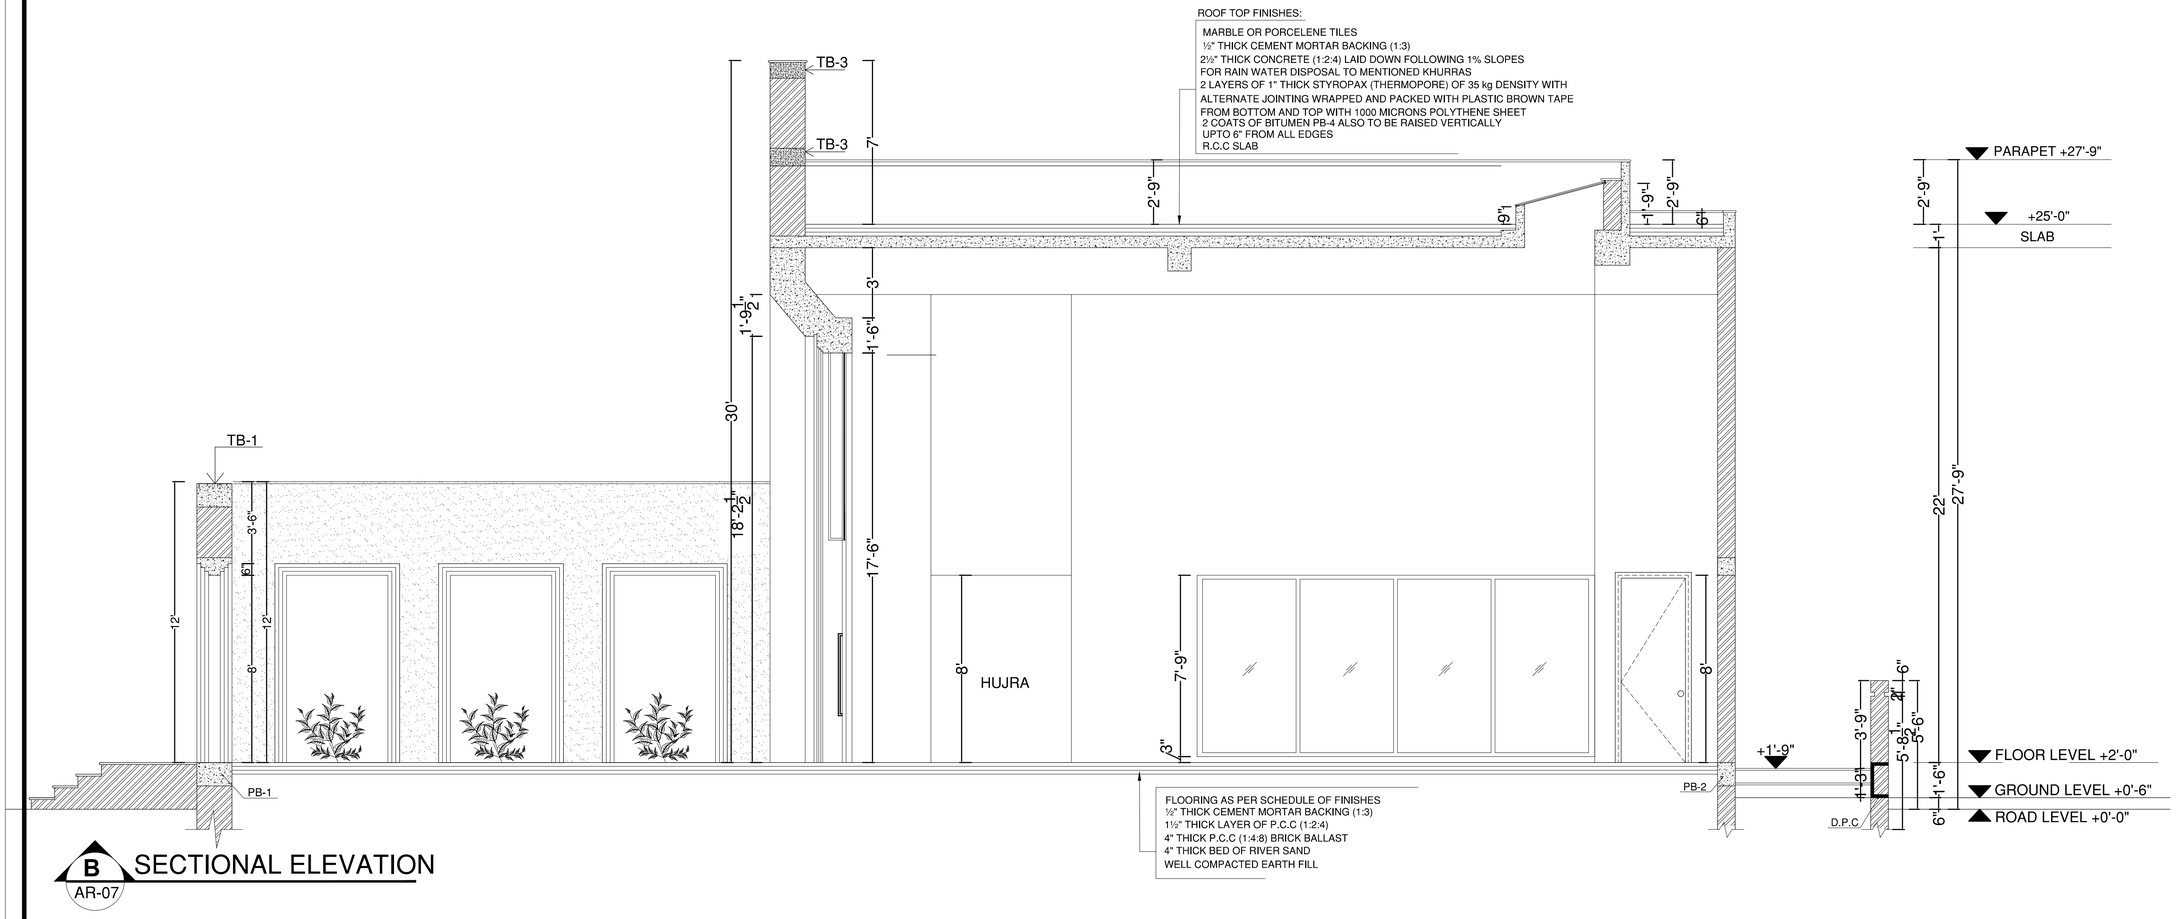

B SECTIONAL ELEVATION
AR-07


NOTE:-
1–FOR GENERAL NOTES SEE DRAWING # S–01 # S–02


PROJECT:
MASJID AT EASTERN HOUSING SCHEME, NEAR QUAID–E–AZAM INTERCHANGE, RING ROAD LAHORE.

DRAWING TITLE:
DETAIL OF PLINTH BEAM & TIE BEAM & SECTION DETAIL


DESIGNED BY: ENGR. ATIQ	DATE: 23–07–2024
CHECKED BY: ENGR. ATIQ	REVISE DATE: 00–00–0000
DRAWN BY: IRFAN	DRAWING. NO. S–06

CONSULTING ENGINEERS:
ATIQ ASSOCIATES
Office # 612, 6th Floor, Al-Qadir Heights,
1-Babar Block, New Garden Town, Lahore.
Tel: 042-35847804, Cell: 0321-8491407
E-Mail: engratiq2000@gmail.com
Web: www.atiqassociates.com

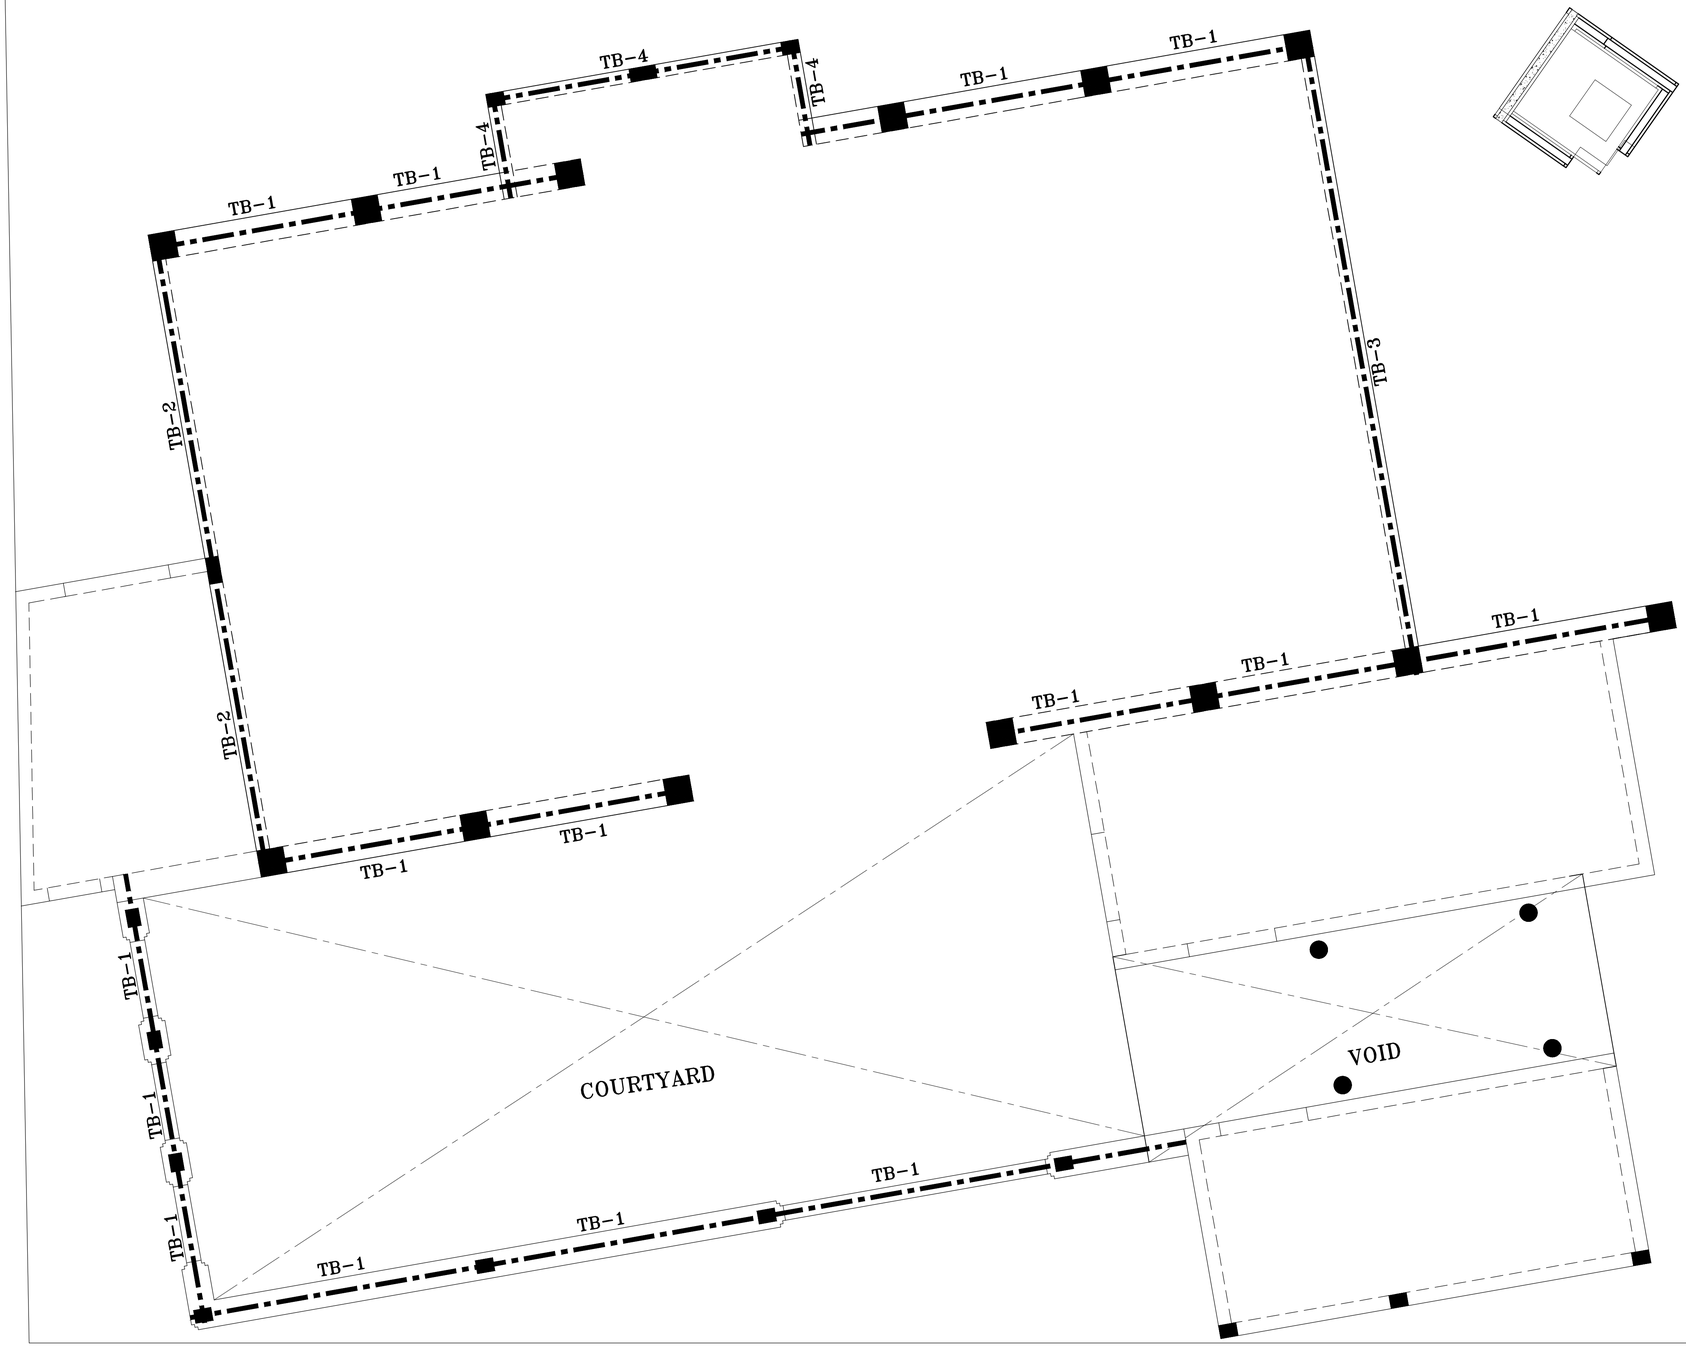


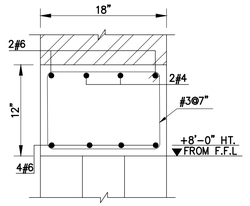


TIE BEAM
TB-1

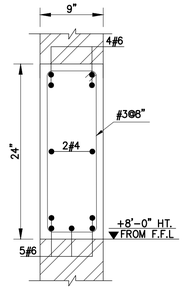

TIE BEAM
TB-2

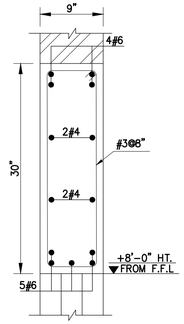

TIE BEAM
TB-3

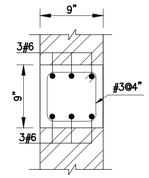

TB-4

NOTE:-

1-FOR GENERAL NOTES SEE DRAWING # S-01 # S-02


2-FOR BEAM DETAILS SEE DRAWING # S-04

PROJECT:
MASJID AT EASTERN HOUSING SCHEME, NEAR QUAID-E-AZAM INTERCHANGE, RING ROAD LAHORE.

DRAWING TITLE:
TIE BEAM PLAN & SECTION DETAIL (AT 8'-0" HT.)

DESIGNED BY: ENGR. ATIQ	DATE: 23-07-2024
CHECKED BY: ENGR. ATIQ	REVISE DATE: 00-00-0000
DRAWN BY: IRFAN	DRAWING. NO. S-07

CONSULTING ENGINEERS:
ATIQ ASSOCIATES
Office # 612, 6th Floor, Al-Qadir Heights,
1-Babar Block, New Garden Town, Lahore.
Tel: 042-35847804, Cell: 0321-8491407
E-Mail: engratiq2000@gmail.com
Web: www.atiqassociates.com

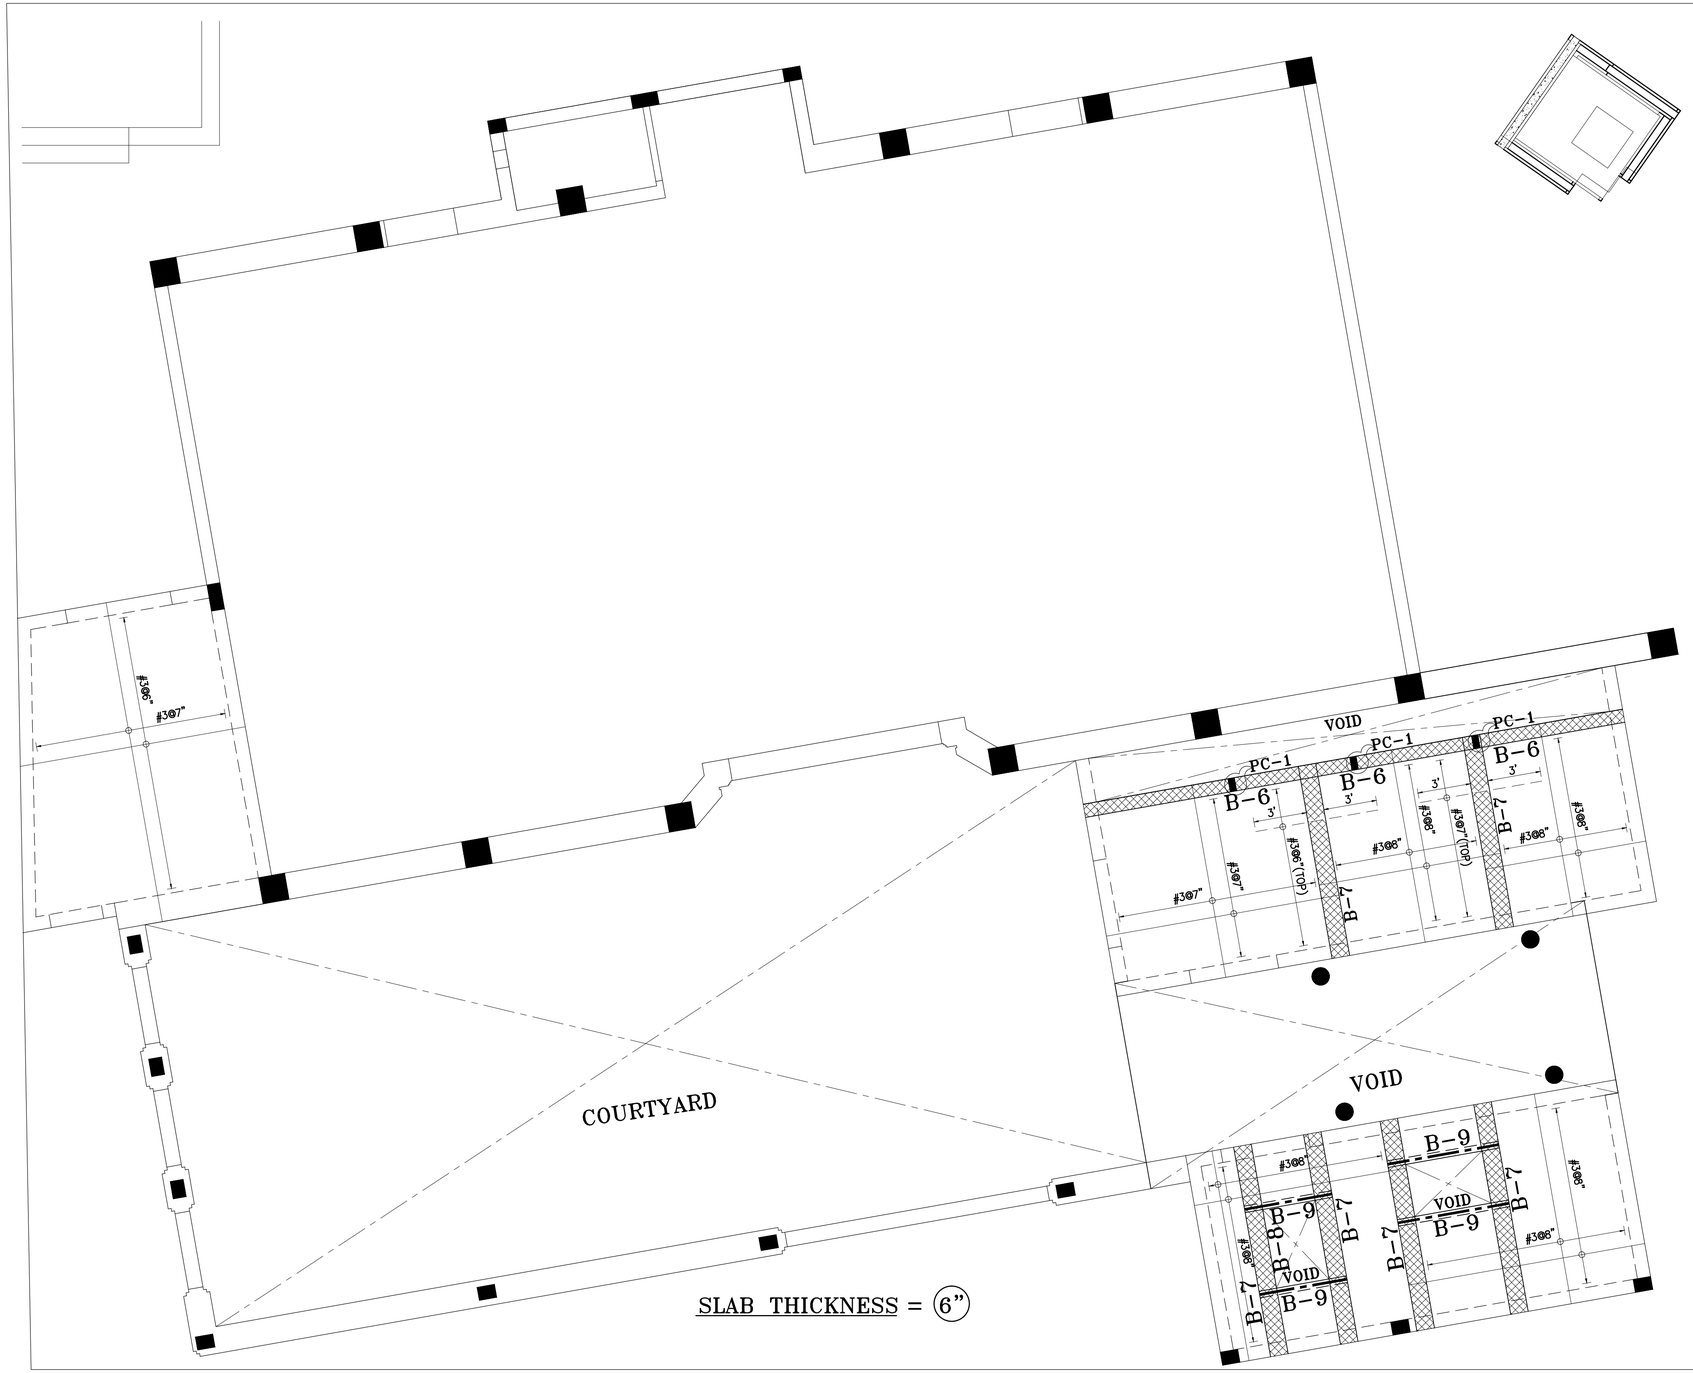

SLAB THICKNESS = (6")

NOTE:-

1-FOR GENERAL NOTES SEE DRAWING # S-01 # S-02


2-FOR BEAM DETAILS SEE DRAWING # S-04

PROJECT:
MASJID AT EASTERN HOUSING SCHEME,
NEAR QUAID-E-AZAM INTERCHANGE,
RING ROAD LAHORE.


DRAWING TITLE:
REINFORCEMENT PLAN OF SLAB
OVER GROUND FLOOR (AT 10'-0" HT.)

DESIGNED BY: ENGR. ATIQ	DATE: 23-07-2024
CHECKED BY: ENGR. ATIQ	REVISE DATE: 00-00-0000
DRAWN BY: IRFAN	DRAWING. NO. S-08


CONSULTING ENGINEERS:
ATIQ ASSOCIATES
Office # 612, 6th Floor, Al-Qadir Heights,
1-Babar Block, New Garden Town, Lahore.
Tel: 042-35847804, Cell: 0321-8491407
E-Mail: engratiq2000@gmail.com
Web: www.atiqassociates.com

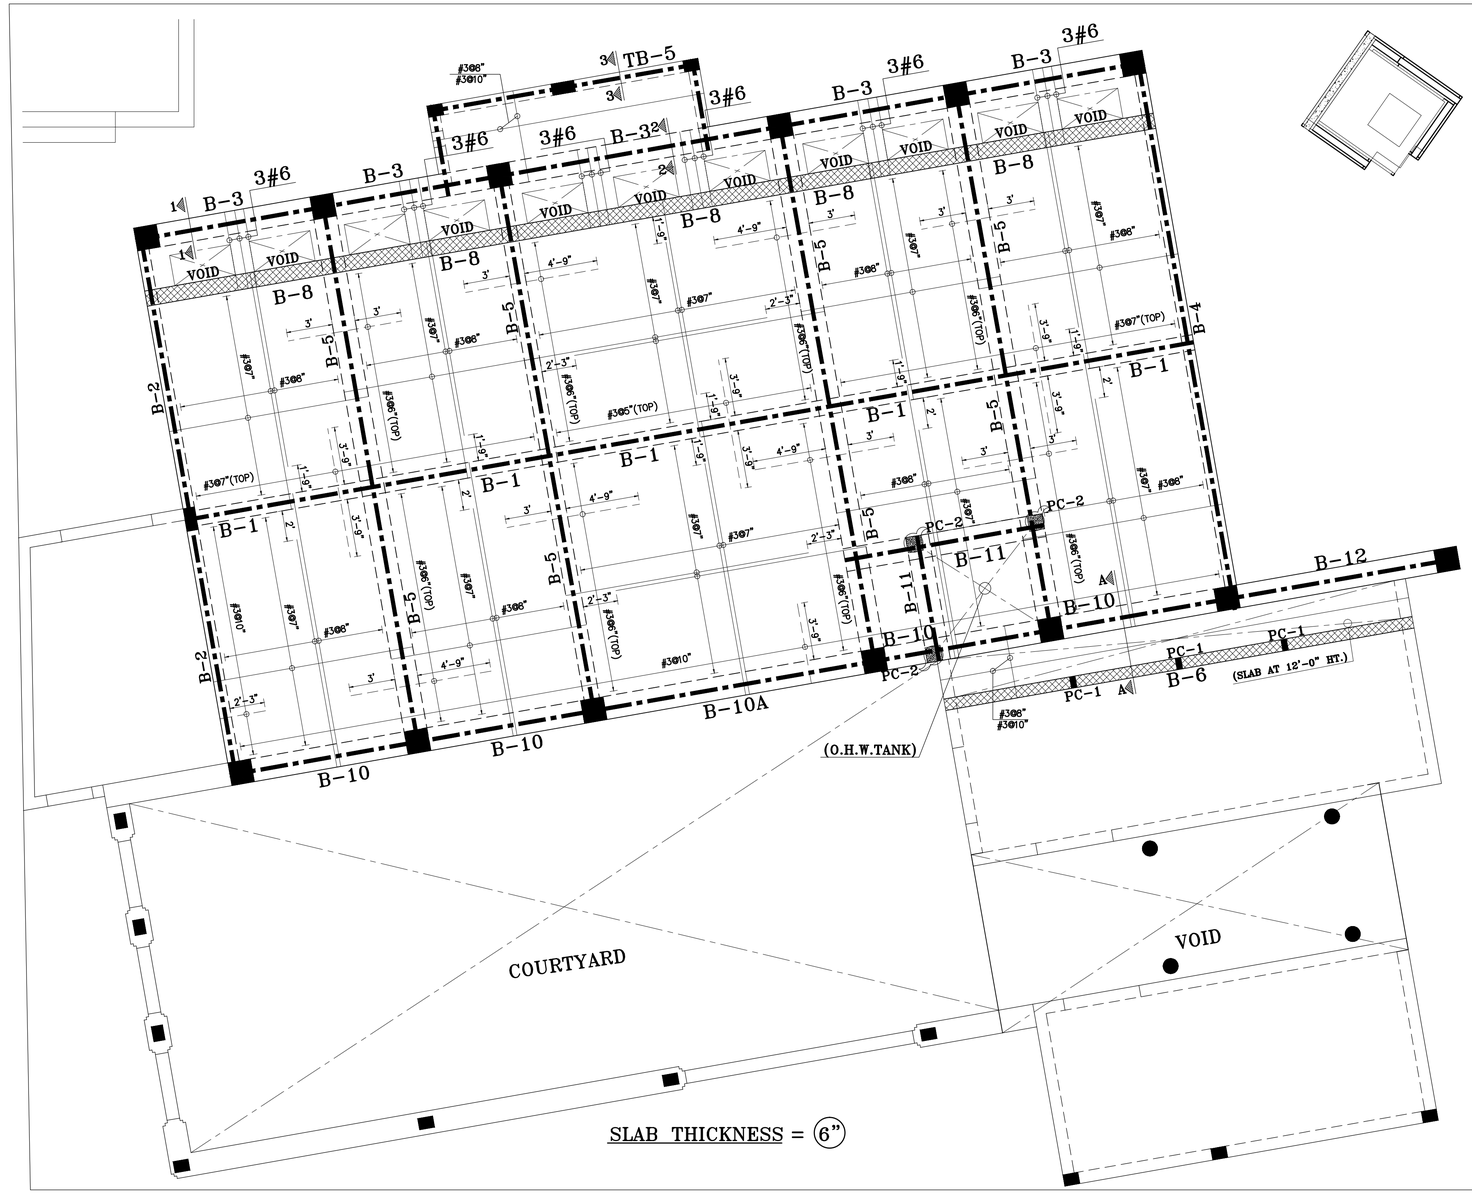


SLAB THICKNESS = (6")

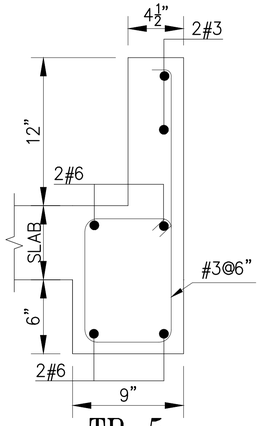

TB-5
(SEC. 3-3)

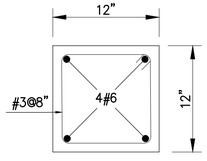

PC-2
FOR O.H.W.TANK
(SEC A-A)

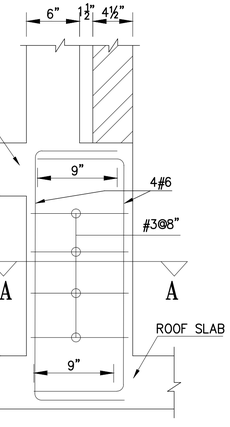

PICKUP COLUMN FROM
ROOF SLAB FOR O.H.W.TANK

NOTE:-


1-FOR GENERAL NOTES SEE DRAWING # S-01 # S-02
2-FOR BEAM DETAILS SEE DRAWING # S-04

PROJECT:
MASJID AT EASTERN HOUSING SCHEME,
NEAR QUAID-E-AZAM INTERCHANGE,
RING ROAD LAHORE.


DRAWING TITLE:
REINFORCEMENT PLAN OF SLAB
OVER GROUND FLOOR (AT 22'-0" HT.)

DESIGNED BY	ENGR. ATIQ	DATE:	23-07-2024
CHECKED BY	ENGR. ATIQ	REVISE DATE:	00-00-0000
DRAWN BY:	IRFAN	DRAWING. NO.	S-09


CONSULTING ENGINEERS:
ATIQ ASSOCIATES
Office # 612, 6th Floor, Al-Qadir Heights,
1-Babar Block, New Garden Town, Lahore.
Tel: 042-35847804, Cell: 0321-8491407
E-Mail: engratiq20000@gmail.com
Web: www.atiqassociates.com

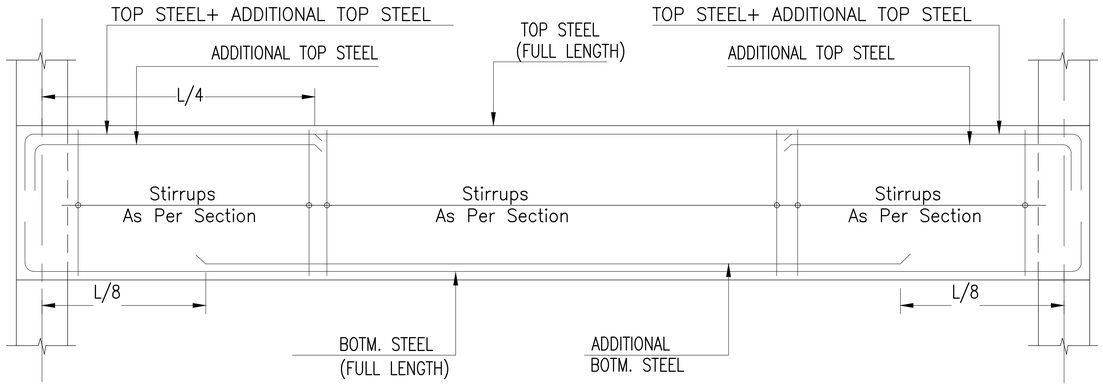


TYPICAL SINGLE SPAN BEAM ELEVATION

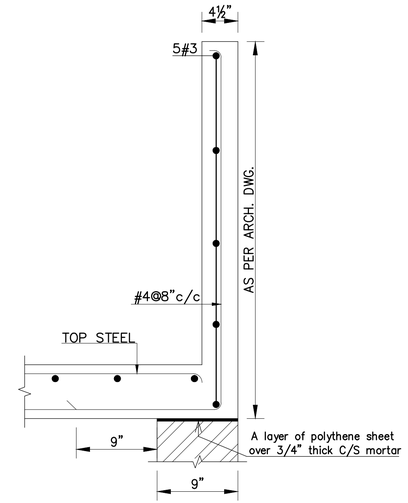

R.C.C. PARAPET WALL DETAIL

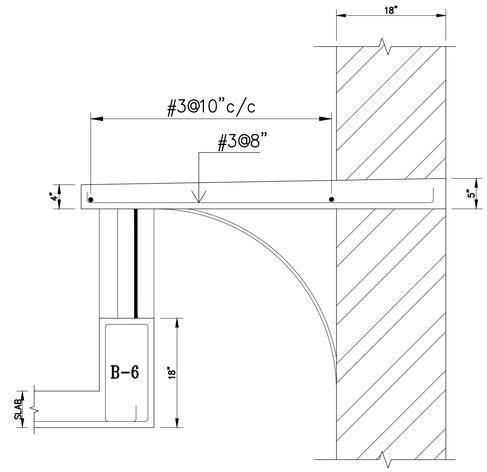

SECTION A-A

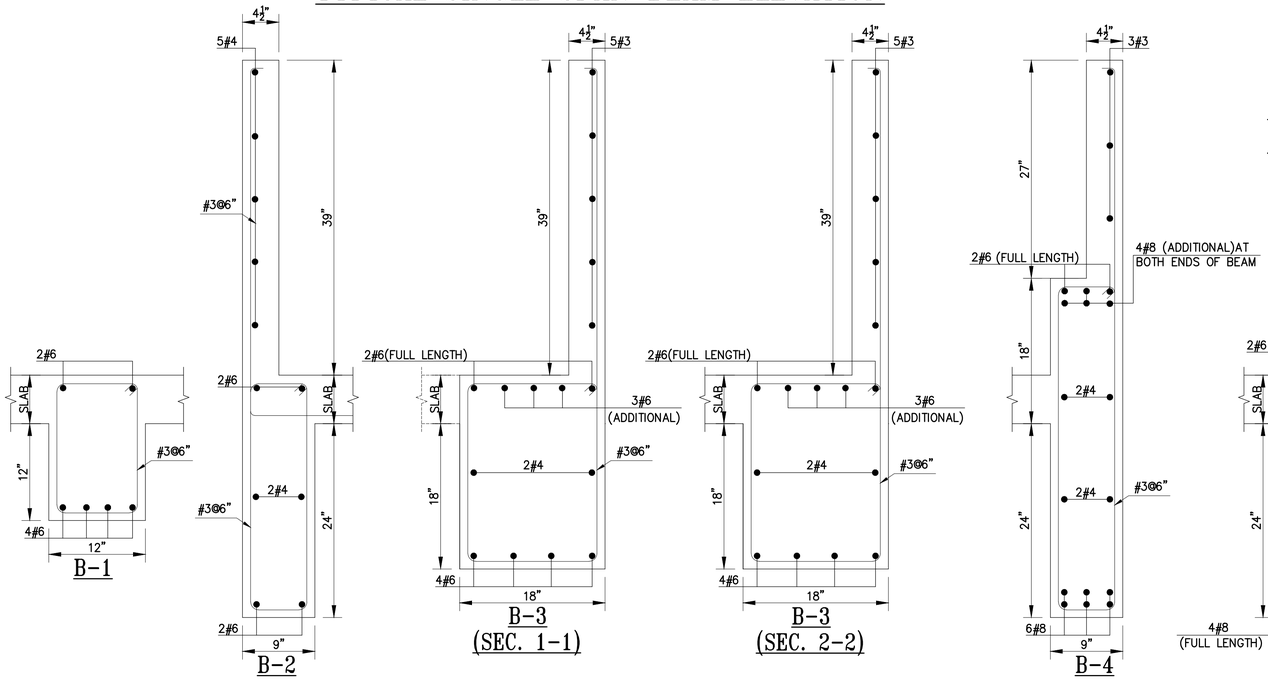

NOTE:-


1-FOR GENERAL NOTES SEE DRAWING # S-01 # S-02

PROJECT:
MASJID AT EASTERN HOUSING SCHEME, NEAR QUAID-E-AZAM INTERCHANGE, RING ROAD LAHORE.


DRAWING TITLE:
BEAM SECTION DETAIL OF SLAB OVER GROUND FLOOR

DESIGNED BY	ENGR. ATIQ	DATE:	23-07-2024
CHECKED BY	ENGR. ATIQ	REVISE DATE:	00-00-0000
DRAWN BY:	IRFAN	DRAWING. NO.	S-10

CONSULTING ENGINEERS:
ATIQ ASSOCIATES
Office # 612, 6th Floor, Al-Qadir Heights, 1-Babar Block, New Garden Town, Lahore.
Tel: 042-35847804, Cell: 0321-8491407
E-Mail: engratiq2000@gmail.com
Web: www.atiqassociates.com

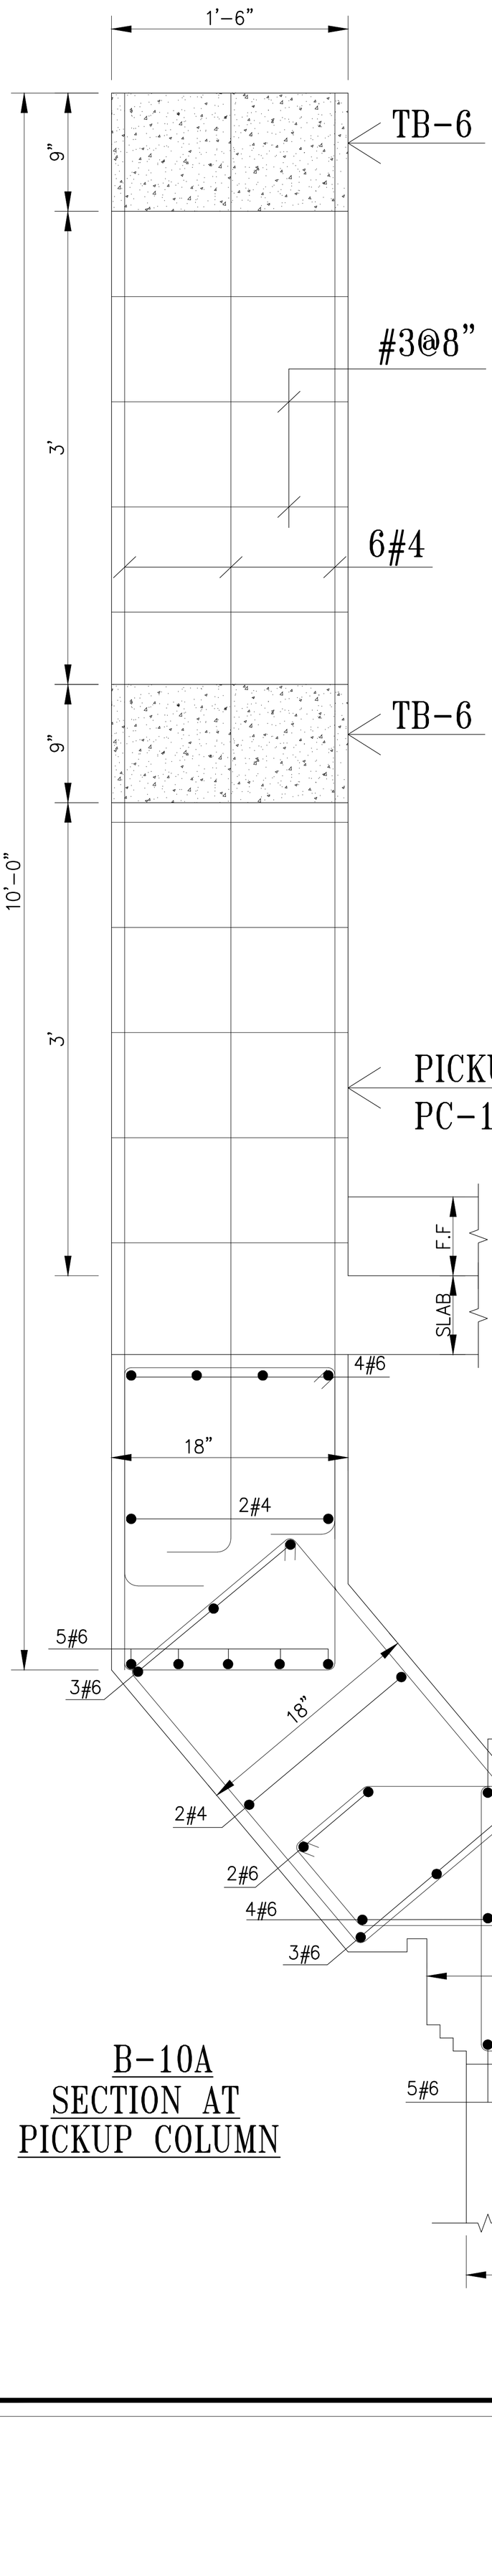


B-10A
SECTION AT
PICKUP COLUMN

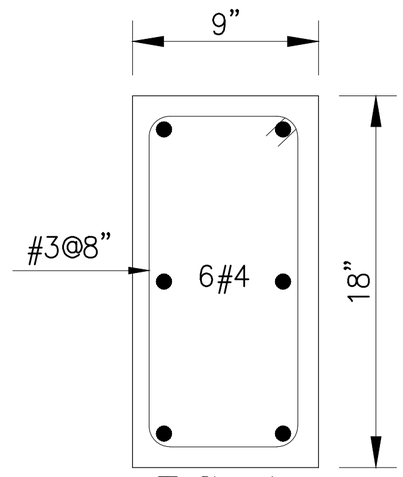


PC-1

PICK UP COLUMN
AT 10'-0" DIST.

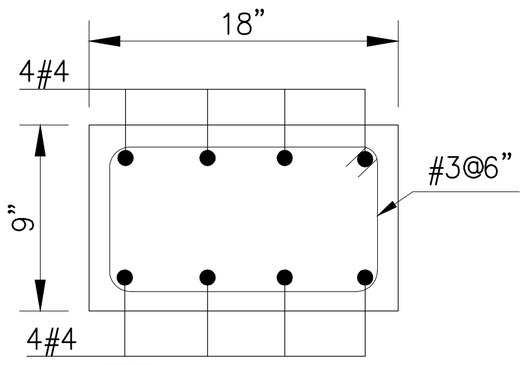

TB-6
TIE BEAM WITH
PICKUP COLUMN

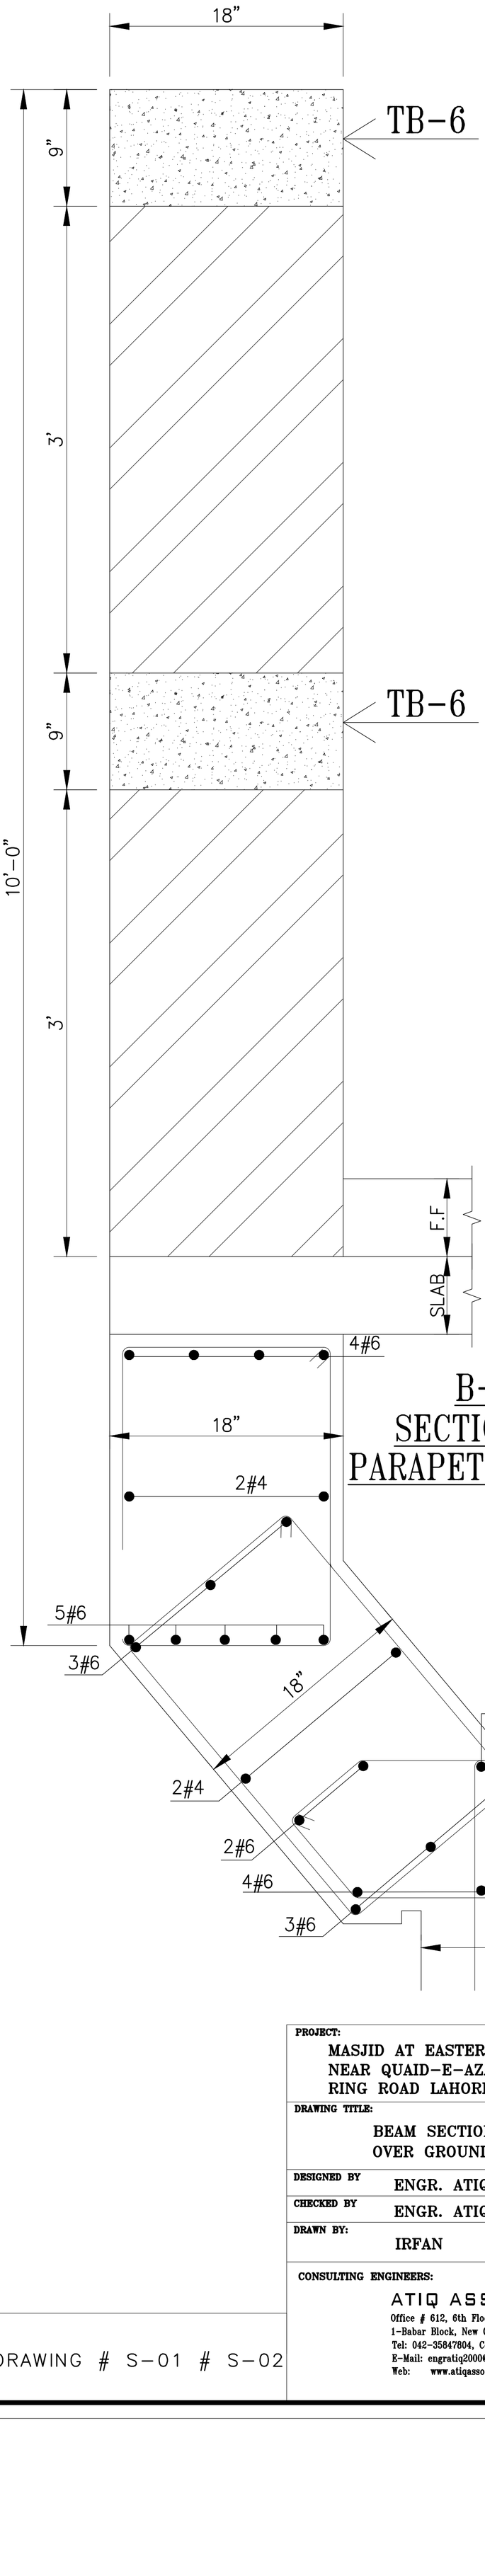


B-10A
SECTION AT
PARAPET BR. WALL


NOTE:-
1-FOR GENERAL NOTES SEE DRAWING # S-01 # S-02

PROJECT: MASJID AT EASTERN HOUSING SCHEME, NEAR QUAID-E-AZAM INTERCHANGE, RING ROAD LAHORE.	
DRAWING TITLE: BEAM SECTION DETAIL OF SLAB OVER GROUND FLOOR	
DESIGNED BY ENGR. ATIQ	DATE: 23-07-2024
CHECKED BY ENGR. ATIQ	REVISE DATE: 09-07-2024
DRAWN BY: IRFAN	DRAWING. NO. S-11

CONSULTING ENGINEERS:
ATIQ ASSOCIATES
Office # 612, 6th Floor, Al-Qadir Heights,
1-Babar Block, New Garden Town, Lahore.
Tel: 042-35847804, Cell: 0321-8491407
E-Mail: engratiq2000@gmail.com
Web: www.atiqassociates.com

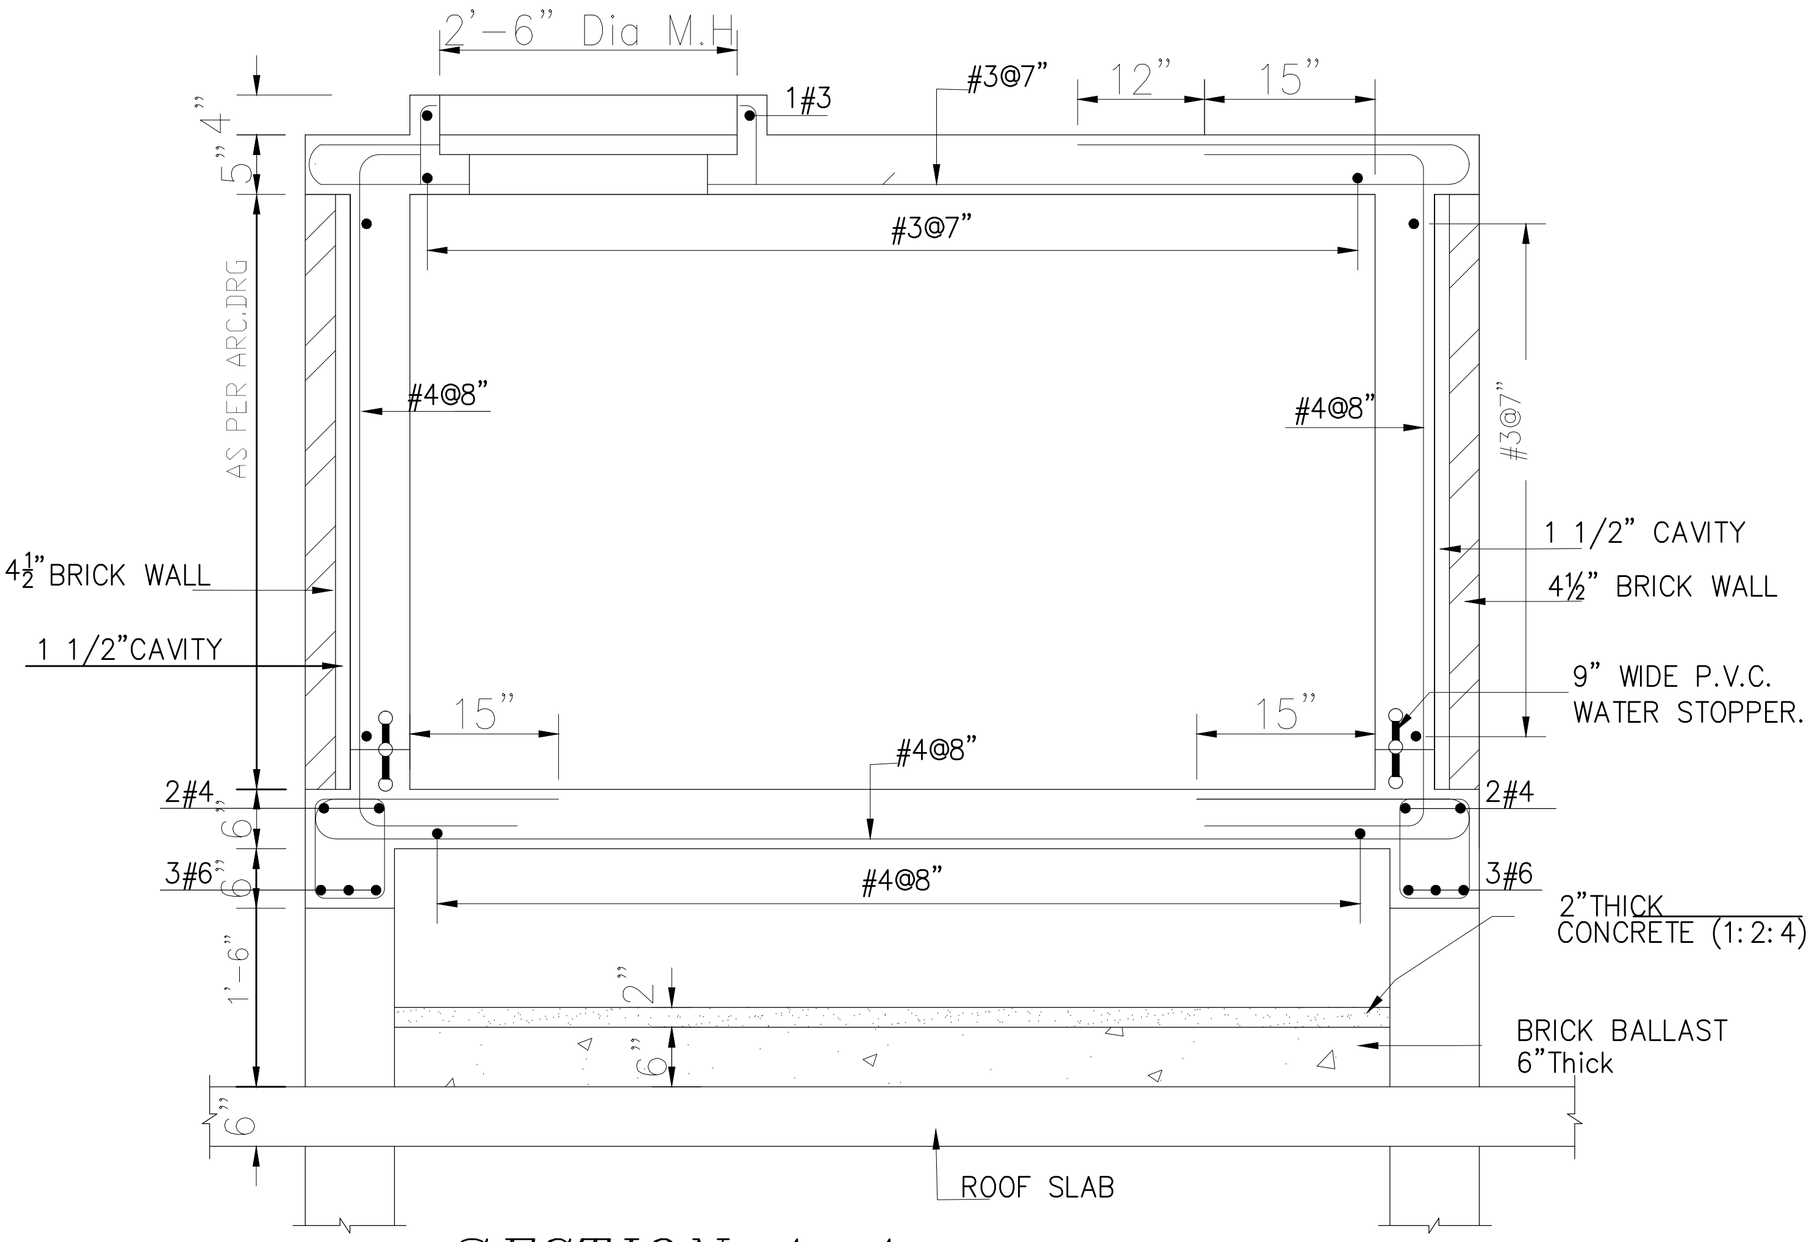

SECTION A-A

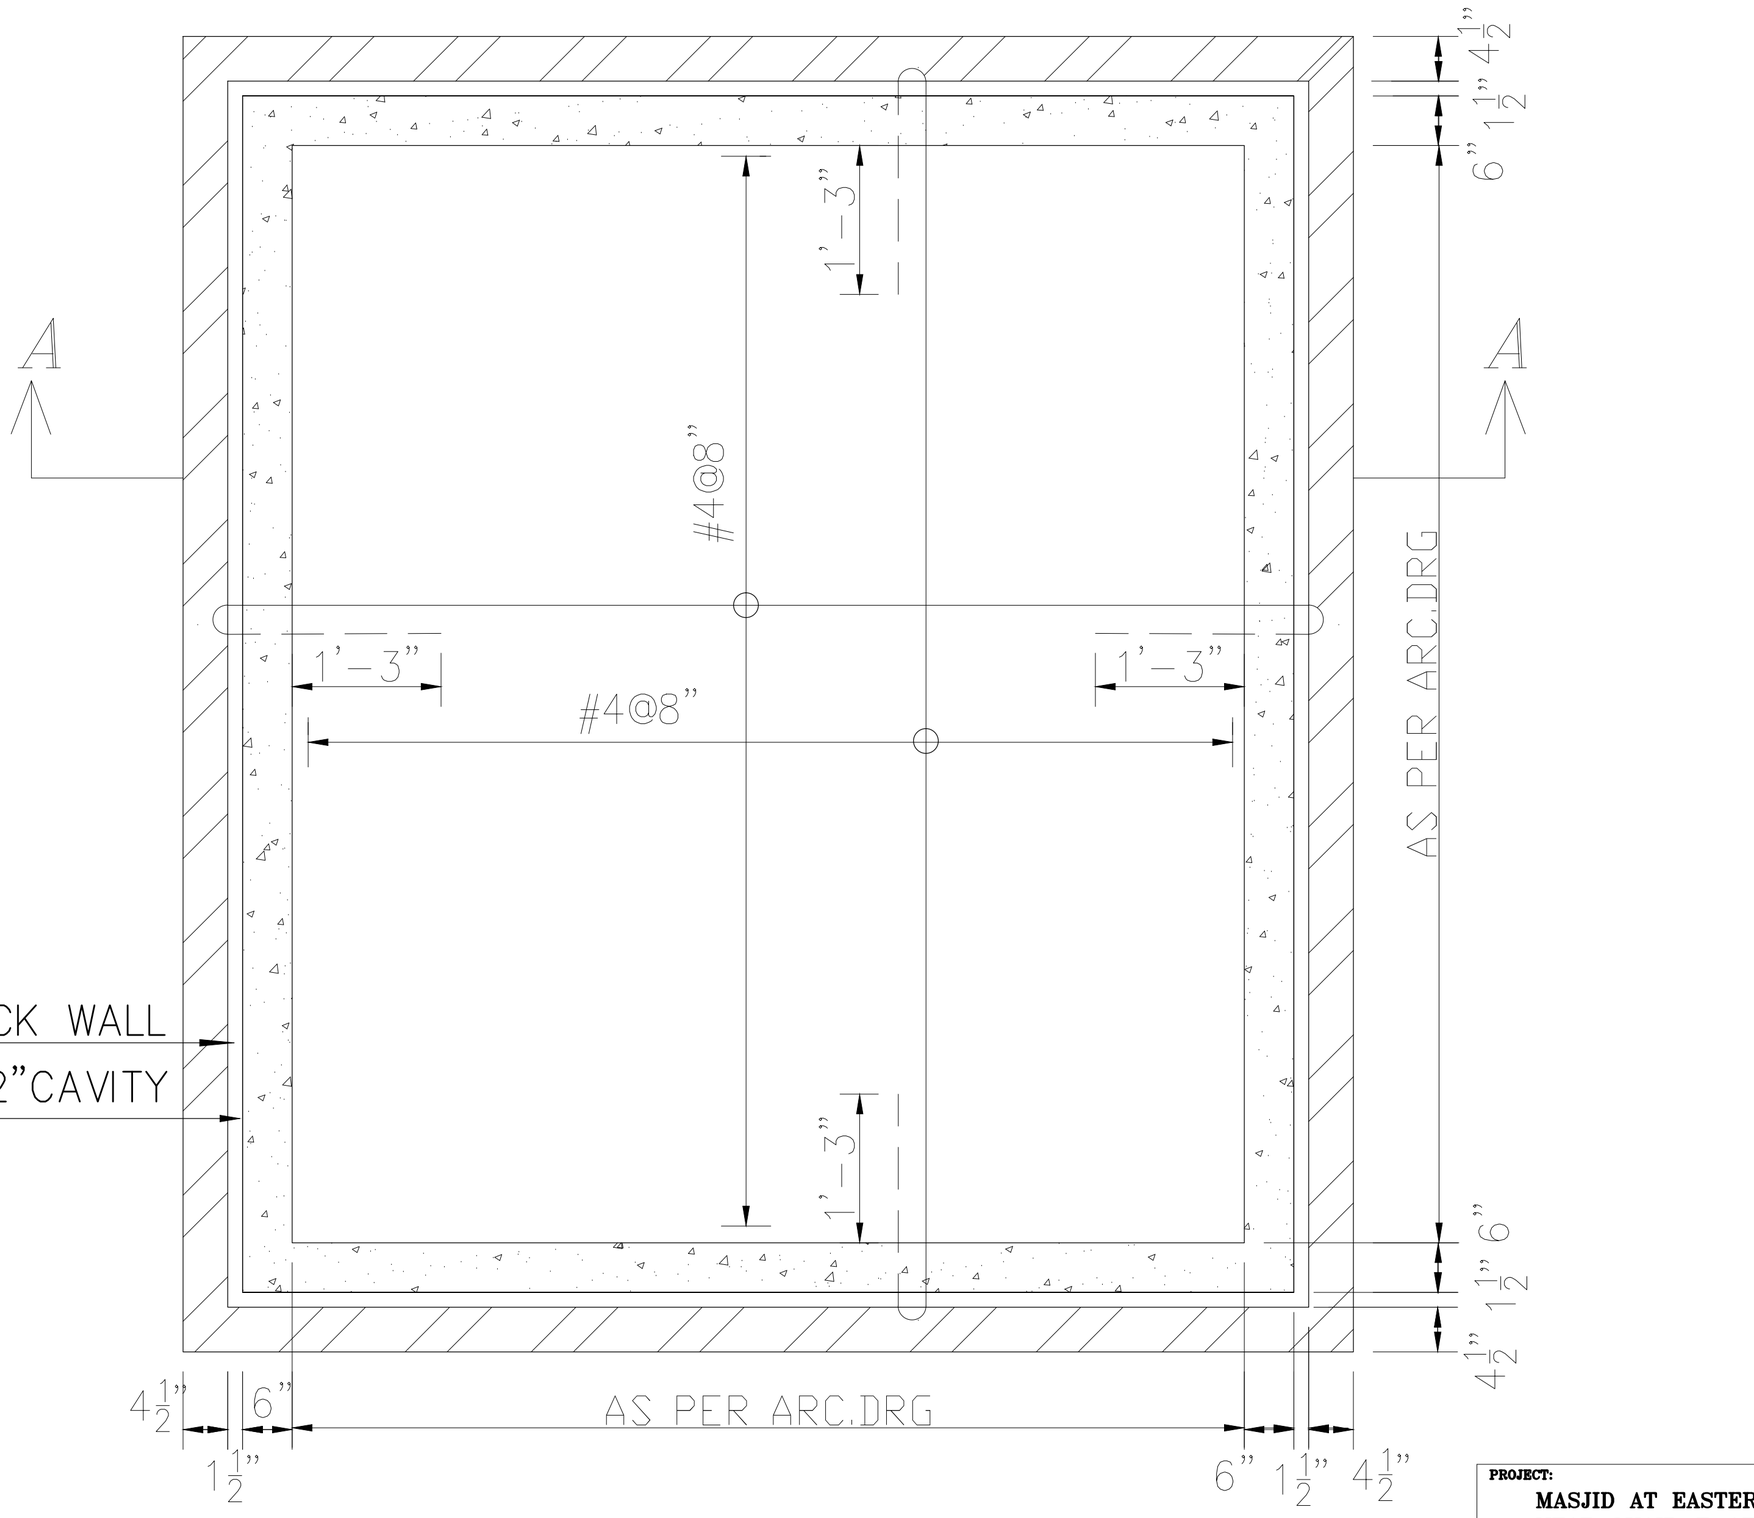

OVER HEAD WATER TANK
BASE SLAB PLAN

NOTE:-


1-FOR GENERAL NOTES SEE DRAWING # S-01 # S-02

PROJECT:
MASJID AT EASTERN HOUSING SCHEME,
NEAR QUAID-E-AZAM INTERCHANGE,
RING ROAD LAHORE.


DRAWING TITLE:
TYPICAL OVER HEAD WATER TANK

DESIGNED BY: ENGR. ATIQ	DATE: 23-07-2024
CHECKED BY: ENGR. ATIQ	REVISE DATE: 09-07-2024
DRAWN BY: IRFAN	DRAWING. NO. S-12


CONSULTING ENGINEERS:
ATIQ ASSOCIATES
Office # 612, 6th Floor, Al-Qadir Heights,
1-Babar Block, New Garden Town, Lahore.
Tel: 042-35847804, Cell: 0321-8491407
E-Mail: engratiq2000@gmail.com
Web: www.atiqassociates.com

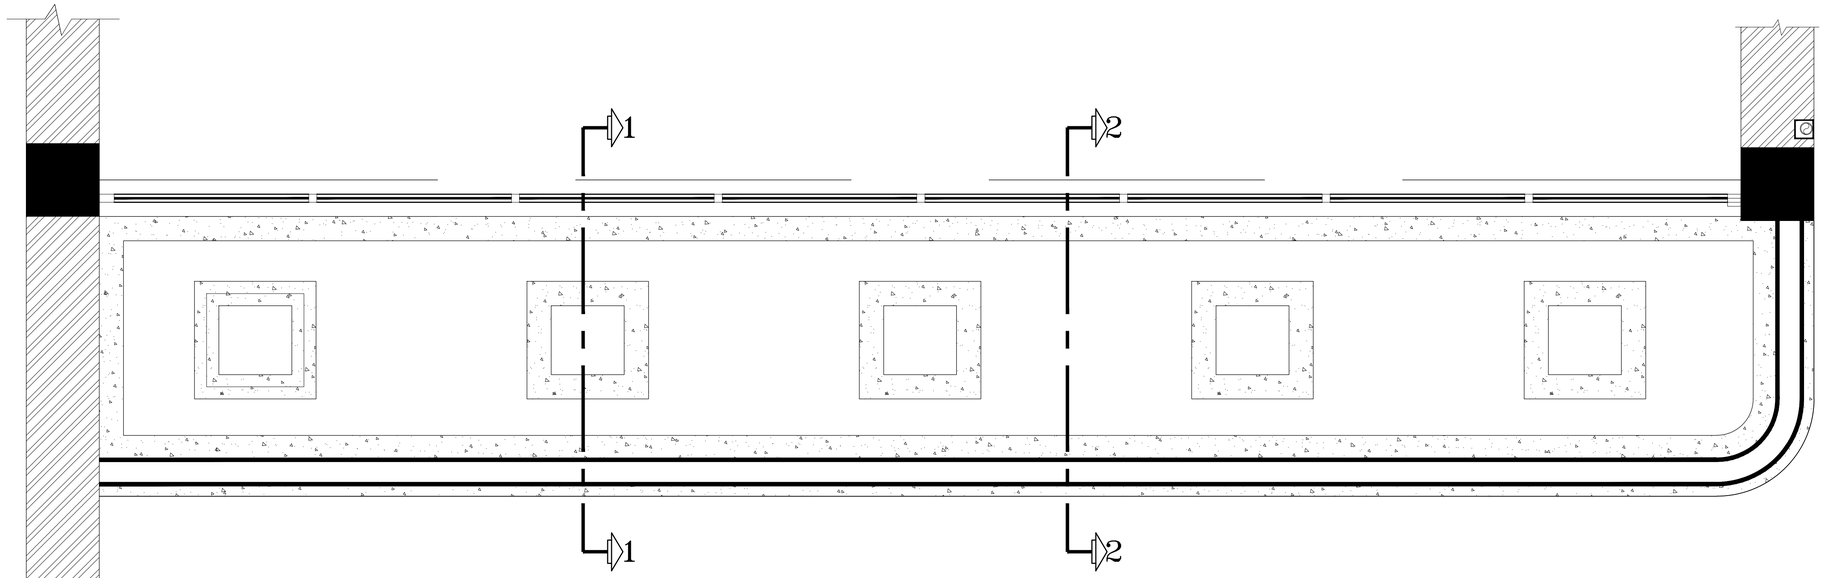

WATER BODY & PLANTER PLAN

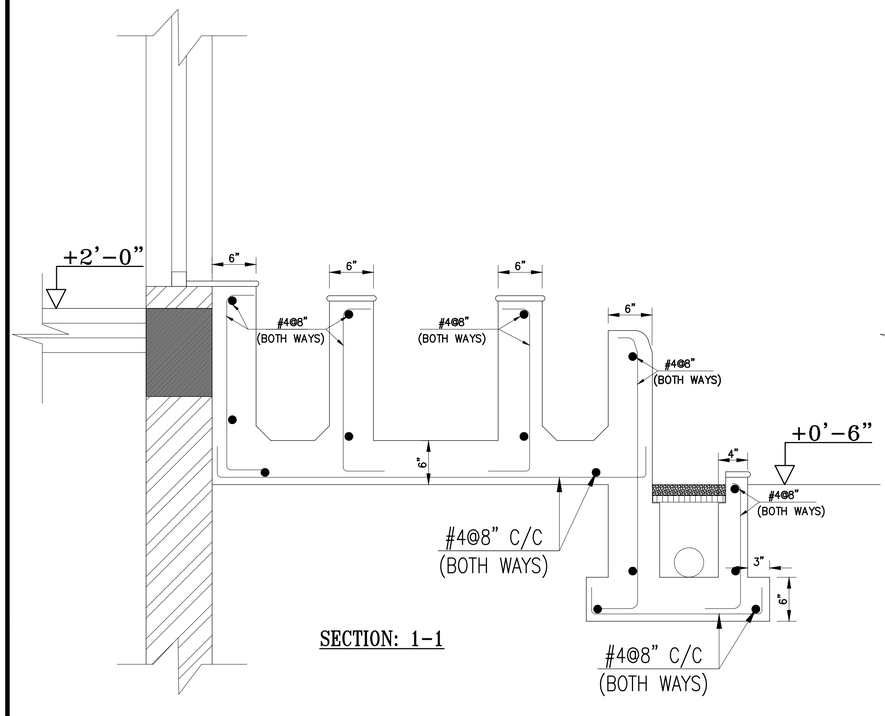

SECTION: 1-1

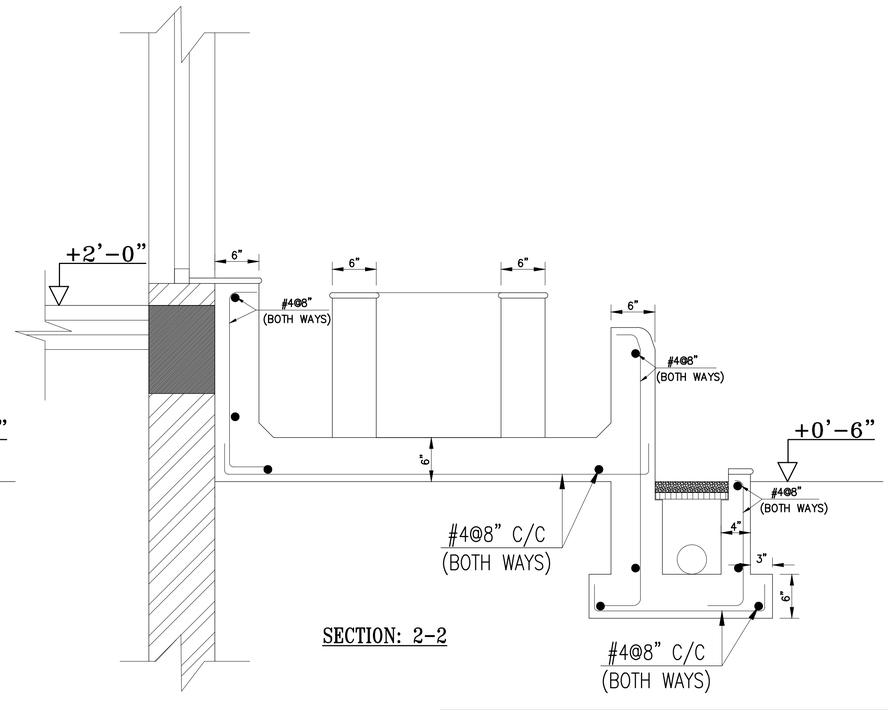

SECTION: 2-2

NOTE:-


1-FOR GENERAL NOTES SEE DRAWING # S-01 # S-02
2-FOR FOOTING DETAILS SEE DRAWING # S-04

PROJECT:
MASJID AT EASTERN HOUSING SCHEME, NEAR QUAID-E-AZAM INTERCHANGE, RING ROAD LAHORE.

DRAWING TITLE:
WATER BODY & PLANTER PLAN & SECTION DETAIL

DESIGNED BY	ENGR. ATIQ	DATE:	08-07-2024
CHECKED BY	ENGR. ATIQ	REVISE DATE:	00-00-0000
DRAWN BY:	IRFAN	DRAWING. NO.	S-03A

CONSULTING ENGINEERS:
ATIQ ASSOCIATES
Office # 612, 6th Floor, Al-Qadir Heights,
1-Babar Block, New Garden Town, Lahore.
Tel: 042-35847804, Cell: 0321-8491407
E-Mail: engratiq2000@gmail.com
Web: www.atiqassociates.com

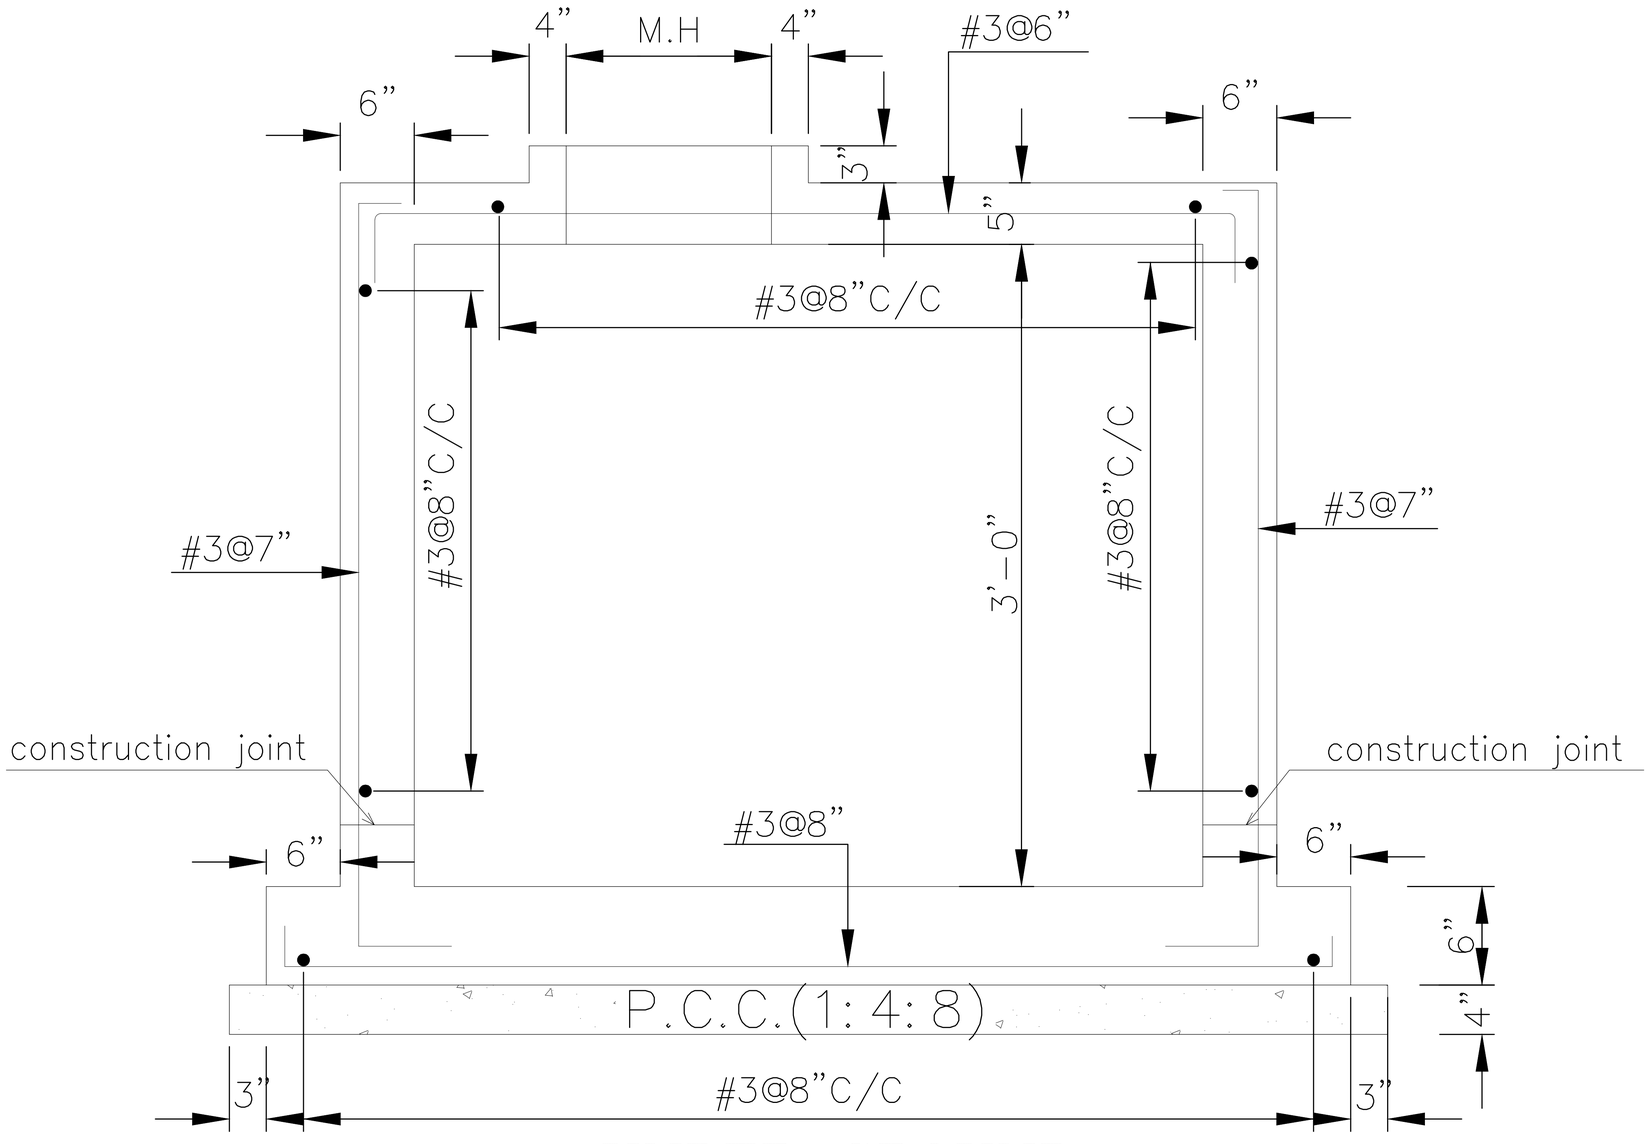

UNDER GROUND WATER TANK 3’–0”X3’–0” DEEP 3’–0”

NOTE:-

1–FOR GENERAL NOTES SEE DRAWING # S–01 # S–02

PROJECT:	MASJID AT EASTERN HOUSING SCHEME, NEAR QUAID–E–AZAM INTERCHANGE, RING ROAD LAHORE.
DRAWING TITLE:	UNDER GROUND WATER TANK
DESIGNED BY ENGR. ATIQ	**DATE:** 08–07–2024
CHECKED BY ENGR. ATIQ	**REVISE DATE:** 00–00–0000
DRAWN BY: IRFAN	**DRAWING. NO.** S–04A

CONSULTING ENGINEERS:

ATIQ ASSOCIATES

Office # 612, 6th Floor, Al-Qadir Heights,
1-Babar Block, New Garden Town, Lahore.
Tel: 042-35847804, Cell: 0321-8491407
E-Mail: engratiq2000@gmail.com
Web: www.atiqassociates.com























